

HARRISON

F66

11-1-69

MISSISSIPPI
 BOARD OF WATER COMMISSIONERS
 416 North State Street
 Jackson, Mississippi 39201

CODED

WATER WELL DRILLERS LOG

11-1 1969
date well completed

R. J. Moore
firm name

HARRISON
county well located

LANDOWNER: John W Ferguson

PT #2 Box 179

Gulfport

(mailing address)

WELL LOCATION:

sec. 7 T. 6 N. R. 12 E.

LIZANA Community

(distance) miles (direction) of (nearest town)

WELL PURPOSE:

(Home, Irrigation, municipal, Industrial)

WELL COMPLETION DATA:

- (1) diameter (inches) 2"
- (2) total depth (feet) 129
- (3) static water level (feet) 50' below above top of ground.
- (4) casing 95 169
(material) (depth)
2" if telescope see back.
(size)
- (5) screen 2x10 169
(length) (depth to top)
2' 95
(size) (material)
- (6) pump 1 600 HR
(HP) (yield gpm)
ELCC
(type power)
- (7) electric log
(yes or no)

(organization running log)

(8) how well bottom plugged B.W.

VALVE

DRILLERS REMARKS:

description of formations encountered

from

to

TOP SOIL

0 10

RED SAND + clay

10 30

White clay

30 41

Blue clay

41 104

FINE SAND

104 135

Blue clay

135 156

Rusty sand

156 177


Blue clay

177 179

NOV 12 1969
MISS. Bd. of WATER COM.

If well telescopes please sketch and show depths.

GROUND LEVEL

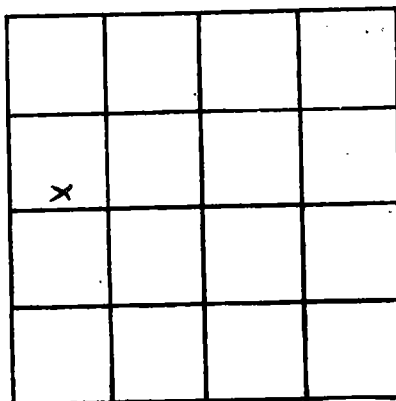

SECTION _____

Please indicate well location X.

ADDITIONAL INFORMATION

If more than one screen, show locations of each on sketch.