

Harrison
 F 70
 3-17-70

MISSISSIPPI
 BOARD OF WATER COMMISSIONERS
 416 North State Street
 Jackson, Mississippi 39201

WATER WELL DRILLERS LOG

CODED

March 17 1970 McGill Well Works Harrison
 date well completed firm name county well located

LANDOWNER: Ferry Gartin
 Rt 2 - Box 388
 Gulfport, Miss
 (billing address)

WELL LOCATION:
 sec 22 6 N R 12 E
4 miles West of Loman
 (distance) (direction) (nearest town)

WELL PURPOSE: Home
 (home, irrigation, municipal, industrial)

WELL COMPLETION DATA:
 (1) diameter (inches) 2"
 (2) total depth (feet) 475'
 (3) static water level (feet) 42' below above top of ground.
 (4) casing None
 (material) (depth)
No If telescope see back.
 (size)
 (5) screen 10'
 (length) (depth to top)
2" Stainless Steel
 (size) (material)
 (6) pump 1 HP 14 g.p.m.
 (HP) (yield gpm)
Electric
 (type power)
 (7) electric log No
 (yes or no)
No
 (organization running log)
 (8) how well bottom plugged Sand
SHARK

description of formations encountered	from	to
0' - 15' Top soil	0'	15'
Clay	15'	40'
Blue Mud	40'	160'
Shell	160'	180'
Blue Mud	180'	470'
SAND	470'	475'

CODED


APR 10 1970

MISS. BD. OF
 WATER COM.

DRILLERS REMARKS: NONE

If well telescopes please sketch and show depths.

GROUND LEVEL

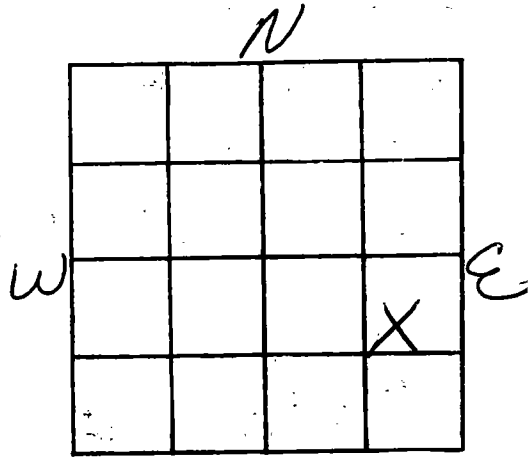

SECTION 22

Please indicate well location X.

ADDITIONAL INFORMATION

Lined area for additional information.

If more than one screen, show locations of each on sketch.