

Harrison
 F 75
 5-6-70

MISSISSIPPI
 BOARD OF WATER COMMISSIONERS
 416 North State Street
 Jackson, Mississippi 39201

CODED

WATER WELL DRILLERS LOG

576³ 1970 Coastal Drilling Co. Harrison
 date well completed firm name county well located

LANDOWNER: D. T. Farlow
 Rt 2, Box 409
 Apt. Miss
 (mailing address)

WELL LOCATION:
 sec 24 T 6 N R 12 E 204
 (distance) (direction) (nearest town)
 (4) 7 miles W Ferris

WELL PURPOSE: home
 (home, irrigation, municipal, industrial)

WELL COMPLETION DATA:
 (1) diameter (inches) 2"
 (2) total depth (feet) 258
 (3) static water level (feet) 42 below top of ground.
 (4) casing galv 248 (material) (depth)
 (size) if telescope see back.
 (5) screen 10' 248 (length) (depth to top)
 2" S.S. (size) (material)
 (6) pump 1/4 HP 18 (type power) (yield gpm)
 (7) electric log no (yes or no)

(organization running log)

(8) how well bottom plugged
 2" backwashable

DRILLERS REMARKS:
 very good well


description of formations encountered	from	to
Top Soil	1	3
Red Clay	5	13
White Sand	13	27
Red Clay	27	48
Hard Blue Clay	48	200
Coarse Sand	200	220
Gravel	220	230
Coarse sand	230	258

JUN 11 1970

MISS. BD. OF WATER COMM.

If well telescopes please sketch and show depths.

GROUND LEVEL

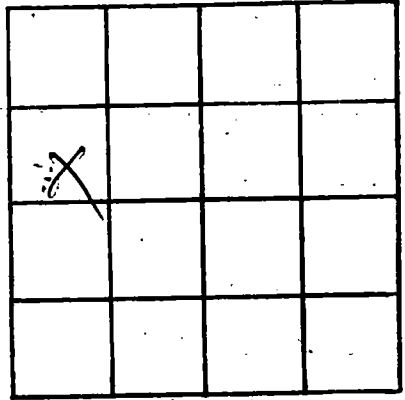

SECTION _____

Please indicate well location X.

ADDITIONAL INFORMATION

If more than one screen, show locations of each on sketch.