

Harrison
F 18
6-10-70

MISSISSIPPI
 BOARD OF WATER COMMISSIONERS
 416 North State Street
 Jackson, Mississippi 39201

WATER WELL DRILLERS LOG

6/10/70 19 Coastal Wells, Inc. Harrison
 (date well completed) (firm name) (county well located)

LANDOWNER: HA. Johnson
St 2
Sulphur Miss
 (mailing address)

WELL LOCATION:
 sec. 7 T. 6 N. R. 12 W.
None miles E of Liana
 (distance) (direction) (nearest town)

WELL PURPOSE: None
 (home, irrigation, municipal, industrial)

WELL COMPLETION DATA:
 (1) diameter (inches) 2x4"
 (2) total depth (feet) 637
 (3) static water level (feet) 66 below above top of ground.
 (4) casing glue 627
 (material) (depth)
2x4" if telescope see back.
 (size)
 (5) screen 10' 627
 (length) (depth to top)
2" 35
 (size) (material)
 (6) pump 3/4 22
 (HP) (yield gpm)
El
 (type power)
 (7) electric log no
 (yes or no)

description of formations encountered	from	to
top soil	1	7
Red Clay	7	13
W. fine sand	13	28
hard Blue Clay	28	140
fine water sand	140	157
hard Blue Clay	157	402
fine water sand	402	420
hard Blue Clay	420	513
fine water sand	513	560
Coarse water sand	560	565
Blue Clay	565	600
fine water sand	600	610
Coarse water sand	610	637

(8) how well bottom plugged 2 feet with sand
 DRILLERS REMARKS:
None

JUL 14 1970

MISS. BD. OF
 WATER COMMISSIONERS


If well telescopes please sketch and show depths.

GROUND LEVEL

147' 4" Casing

480' 2" Casing

10' 2" S.S. Screen
2" lockwork Valve

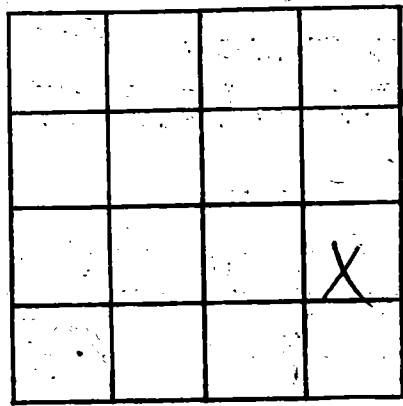

SECTION _____

Please indicate well location X.

ADDITIONAL INFORMATION

If more than one screen, show locations of each on sketch.