

Harrison
F 81
7-7-70

MISSISSIPPI
 BOARD OF WATER COMMISSIONERS
 416 North State Street
 Jackson, Mississippi 39201

WATER WELL DRILLERS LOG

July 7 1970 R. J. Moore-HARRISON
 date well completed firm name county well located


LANDOWNER: <u>Joley Lindsey</u> <u>P.O. 643</u>	description of formations encountered	from	to
<u>Gulfport, MISS</u> (mailing address)			
WELL LOCATION: sec. <u>15</u> T. <u>6</u> N. R. <u>12</u> E. <u>4</u> miles <u>WEST</u> of <u>LYMAN</u> (distance) (direction) (nearest town)	<u>TOP SOIL</u>	<u>0</u>	<u>20</u>
	<u>Red Sand</u>	<u>20</u>	<u>20</u>
	<u>Blue Clay</u>	<u>70</u>	<u>196</u>
	<u>Blue Sand</u>	<u>196</u>	<u>200</u>
	<u>Blue Clay</u>	<u>200</u>	<u>218</u>
	<u>FINE SILTY Sand</u>	<u>218</u>	<u>249</u>
	<u>Blue Clay</u>	<u>249</u>	<u>297</u>
	<u>GRAY SAND (med)</u>	<u>297</u>	<u>324</u>
WELL PURPOSE: <u>(home)</u> , Irrigation, municipal, Industrial)			
WELL COMPLETION DATA: (1) diameter (inches) <u>2"</u>			
(2) total depth (feet) <u>325'</u>			
(3) static water level (feet) <u>81'</u> <u>below</u> above top of ground			
(4) casing <u>942</u> , <u>316'</u> (material) (depth)			
(size) If telescope see back.			
(5) screen <u>2x10</u> , <u>320'</u> (length) (depth to top)			
<u>2'</u> , <u>85</u> (size) (material)			
(6) pump <u>1</u> , <u>300</u> (HP) (yield gpm)			
<u>Elac</u> (type power)			
(7) electric log <u>✓</u> (yes or no)			
(organization running log)			
(8) how well bottom plugged <u>BW</u> <u>WATER</u>			
DRILLERS REMARKS:			

JUL 10 1970

MISS. Bd. of
 WEP Comm.

If well telescopes please sketch and show depths.

GROUND LEVEL

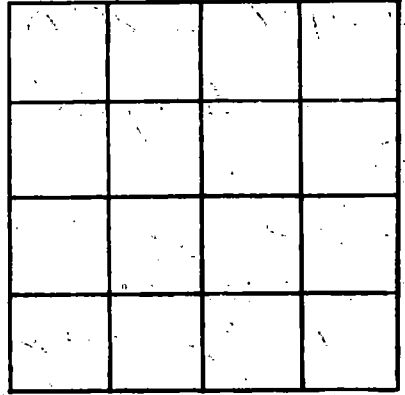

SECTION _____

Please indicate well location X.

ADDITIONAL INFORMATION

If more than one screen, show locations of each on sketch.