

MISSISSIPPI
BOARD OF WATER COMMISSIONERS
416 North State Street
Jackson, Mississippi 39201

CODED

WATER WELL DRILLERS LOG

HARRISON
F 84
8-26-70

8/26 1970
date well completed

Coastal Drilling
firm name

Harrison
county well located

LANDOWNER:

Fair
Concept 2 Bldg Co
Shelby, Miss
(mailing address)

description of formations
encountered

description of formations encountered	from	to
top Soil	1	7
Red Clay	7	18
White Sand	18	84
Blue Clay	84	151
White Sand	151	186
hard Blue Clay	186	218
fine white sand	218	225
Case water Sand	225	242

WELL LOCATION:

sec. 23 T. 6 N. R. 12 E.
Four miles W of Lumberton
(distance) (direction) (nearest town)

WELL PURPOSE:

home
(home, irrigation, municipal, industrial)

WELL COMPLETION DATA:

- diameter (inches) 2'
- total depth (feet) 242
- static water level (feet) 26' below top of ground
- casing glass, 232
(material) (depth)
(size) if telescope see back.
- screen 10' 232
(length) (depth to top)
2" 28
(size) (material)
- pump 1 HP 14
(HP) (yield gpm)
E.L.C.
(type power)
- electric log no
(yes or no)

(organization running log)

(8) how well bottom plugged

2" back wash valve

DRILLERS REMARKS:

None


CODED

SEP 30 1970

MISS. RD. OF
WATER COMM.

If well telescopes please sketch and show depths.

GROUND LEVEL

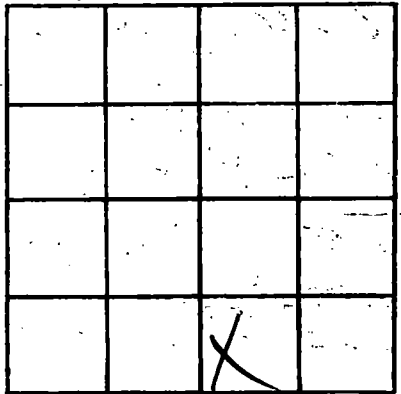

SECTION _____

Please indicate well location X.

ADDITIONAL INFORMATION

A series of horizontal lines for recording additional information.

If more than one screen, show locations of each on sketch.