

HARRISON  
F 87  
10-5-70

MISSISSIPPI  
BOARD OF WATER COMMISSIONERS  
416 North State Street  
Jackson, Mississippi 39201

**CODED**

WATER WELL DRILLERS LOG

Oct 5 1970 P. J. Moore  
date well completed firm name

HARRISON  
county well located

LANDOWNER: Clyde Parker  
Lizana Miss  
P.O. 2, Lot Miss.  
(mailing address)

WELL LOCATION:  
sec. 8 T. 6 N. R. 12 E.  
3/4 miles NE of Lizana  
(distance) (direction) (nearest town)

WELL PURPOSE:  
(home, irrigation, municipal, industrial)

WELL COMPLETION DATA:

- (1) diameter (inches) 2'
- (2) total depth (feet) 232'
- (3) static water level (feet) 45' <sup>below</sup> above top of ground.
- (4) casing Steel (material), 220' (depth)  
if telescope see back.  
(size)
- (5) screen 2x10 (length), 220' (depth to top)  
2" (size), SS (material)
- (6) pump 1 (HP), 360 HR (yield gpm)  
Electric (type power)
- (7) electric log (yes or no)  
(organization running log)
- (8) how well bottom plugged Yes  
2 ft

description of formations encountered	from	to
TOP SOIL	0	16
Red Sand	16	35
Blue to black Clay	35	90
Red Sand	90	125
Blue Clay	125	200
Grey Sand	200	232

**CODED**


OCT 15 1970

MISS. BD. OF  
WATER COMM.

DRILLERS REMARKS:

If well telescopes please sketch and show depths.

GROUND LEVEL

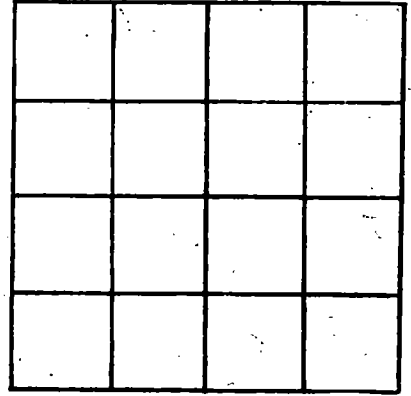

SECTION \_\_\_\_\_

Please indicate well location X.

ADDITIONAL INFORMATION

If more than one screen, show locations of each on sketch.