

HARRISON
F 88
10-29-70

MISSISSIPPI
 BOARD OF WATER COMMISSIONERS
 416 North State Street
 Jackson, Mississippi 39201

CODED

WATER WELL DRILLERS LOG

10-29 1970 R. J. Moore HARRISON
 date well completed firm name county well located

LANDOWNER: W. C. King
Box 256 E
Goldsport Miss S
 (mailing address)

WELL LOCATION:
 sec. 19 T. 6 N. R. 12 E
3/4 miles S of LIZANA
 (distance) (direction) (nearest town)

WELL PURPOSE:
 (home, irrigation, municipal, industrial)

WELL COMPLETION DATA:

- (1) diameter (inches) 2"
- (2) total depth (feet) 334'
- (3) static water level (feet) 66' ^{below} _{above} top of ground.
- (4) casing Pth 324'
 (material) (depth)
 (size) if telescope see back.
- (5) screen 2x10 324'
 (length) (depth to top)
2" SS
 (size) (material)
- (6) pump 1 6
 (HP) (yield gpm)
E
 (type power)
- (7) electric log (yes or no) _____
 (organization running log) _____
- (8) how well bottom plugged Pl
with

description of formations encountered	from	to
TOP SOIL	0	10
Red Clay	10	18
Red Sand	18	40
white clay	40	85
Rusty Sand	85	150
Blue clay	150	210
FINE Sand	210	216
Blue clay	216	310
Blue Sand	310	334

CODED


NOV 10 1970

DRILLERS REMARKS:

MISS. BD. OF
 WATER COM.

If well telescopes please sketch and show depths.

GROUND LEVEL

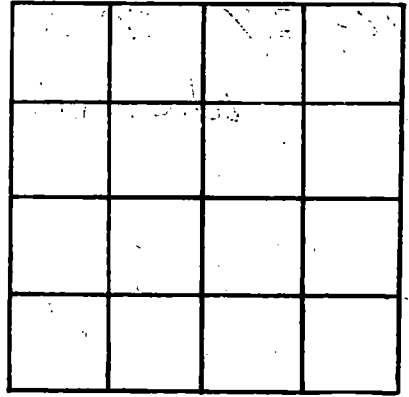

SECTION _____

Please indicate well location X.

ADDITIONAL INFORMATION

If more than one screen,
show locations of each on sketch.