

**HARRISON**  
**F 89**  
**10-31-70**

MISSISSIPPI  
 BOARD OF WATER COMMISSIONERS  
 416 North State Street  
 Jackson, Mississippi 39201

**CODED**

**WATER WELL DRILLERS LOG**

10-31 1970 R. J. Moore HARRISON  
 date well completed firm name county well located

LANDOWNER: MELTON CURVAS

description of formations encountered

PT 2 Bk 258 E  
GULFPORT, MISS  
 (mailing address)

	from	to
<u>TOP SOIL</u>	<u>0</u>	<u>10</u>
<u>Red clay</u>	<u>10</u>	<u>18</u>
<u>Red Sand</u>	<u>18</u>	<u>40</u>
<u>White clay</u>	<u>40</u>	<u>85</u>
<u>Rusty Sand</u>	<u>85</u>	<u>150</u>
<u>Blue clay</u>	<u>150</u>	<u>210</u>
<u>GRAN SAND FINE</u>	<u>210</u>	<u>214</u>
<u>Blue clay</u>	<u>214</u>	<u>215</u>
<u>Blue Sand</u>	<u>215</u>	<u>336</u>

WELL LOCATION:  
 sec. 19 T. 6 N. R. 12 E. S W  
3/4 miles S of LIZMA  
 (distance) (direction) (nearest town)

WELL PURPOSE:  
 (home, irrigation, municipal, industrial)

WELL COMPLETION DATA:

- (1) diameter (inches) 2"
- (2) total depth (feet) 336'
- (3) static water level (feet) 68' <sup>below</sup> <sub>above</sub> top of ground.
- (4) casing 94L2 326'  
 (material) (depth)  
 (size) if telescope see back.
- (5) screen 2x10 326'  
 (length) (depth to top)  
2" SS  
 (size) (material)
- (6) pump 1 6  
 (HP) (yield gpm)  
E  
 (type power)
- (7) electric log             
 (yes or no)  
            
 (organization running log)
- (8) how well bottom plugged BW  
None

**CODED**


NOV 10 1970

DRILLERS REMARKS:

MISS. BD. OF  
 WATER COMM.

If well telescopes please sketch and show depths.

GROUND LEVEL

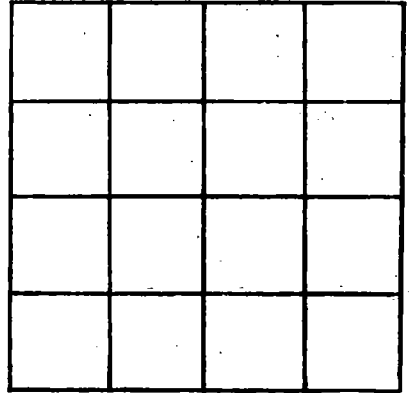

SECTION \_\_\_\_\_

Please indicate well location X.

ADDITIONAL INFORMATION

If more than one screen,  
show locations of each on sketch.