

HARRISON
F 90
9-22-70

MISSISSIPPI
 BOARD OF WATER COMMISSIONERS
 416 North State Street
 Jackson, Mississippi 39201

CODED

WATER WELL DRILLERS LOG

9-22 1970 Switzer Well Co. HARRISON
 date well completed firm name county well located

LANDOWNER: William C. Carter
Carter James Farm
Lizana community
 (mailing address)

WELL LOCATION:
 sec. 17 T. 6 S. R. 12 E. W.
13 miles NW of GULFPORT
 (distance) (direction) (nearest town)

WELL PURPOSE: HOME
 (home, irrigation, municipal, industrial)

WELL COMPLETION DATA:
 (1) diameter (inches) 2"
 (2) total depth (feet) 654'
 (3) static water level (feet) 85 below above top of ground.
 (4) casing galv. 654'
 (material) (depth)
4x2 if telescope see back.
 (size)
 (5) screen 20' 634
 (length) (depth to top)
308 Stainless Steel
 (size) (material)
 (6) pump 1 17
 (HP) (yield gpm)
ELEC.
 (type power)
 (7) electric log NO
 (yes or no)
 (organization running log)
 (8) how well bottom plugged back
pressure valve

description of formations encountered	from	to
Clay	0	20
Sand	20	40
Mixed	40	60
soft clay	60	79
Sand	79	104
Clay	104	158
Sand	158	212
clay	212	247
Sand	247	257
Mixed	257	277
clay	277	432
Sand, fine	432	466
Sand, fine	466	530
Clay	530	560
Sand	560	654


CODED

DEC 21 1970

DRILLERS REMARKS:
 MISS. BD. OF WATER COM.

If well telescopes please sketch and show depths.

GROUND LEVEL

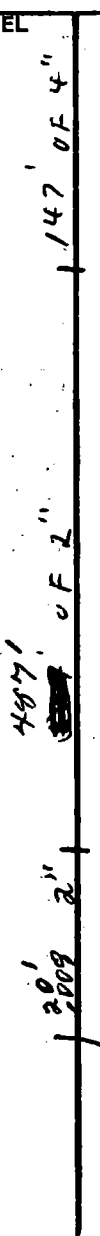

SECTION 17

Please indicate well location X.

ADDITIONAL INFORMATION

If more than one screen, show locations of each on sketch.