

HARRISON  
F 94  
8-17-70

MISSISSIPPI  
BOARD OF WATER COMMISSIONERS  
416 North State Street  
Jackson, Mississippi 39201

**CODED**

WATER WELL DRILLERS LOG


Aug. 17, 1970 19 McGill Well Works Harrison  
date well completed firm name county well located

LANDOWNER:	description of formations encountered	from	to
<u>Curtis Cook</u> <u>Rt. 5, Box 95</u> <u>Gulfport, Miss.</u> (mailing address)			
<b>WELL LOCATION:</b> sec <u>16</u> T <u>6</u> N R <u>12</u> E <u>5 1/2</u> miles <u>West</u> of <u>Lyman</u> (distance) (direction) (nearest town)			
<b>WELL PURPOSE:</b> (home, irrigation, municipal, industrial)			
<b>WELL COMPLETION DATA:</b>			
(1) diameter (inches) <u>2"</u>			
(2) total depth (feet) <u>609'</u>			
(3) static water level (feet) <u>92'</u> <u>below</u> / <u>above</u> top of ground.			
(4) casing <u>gal</u> (material) <u>20'</u> (depth) <u>used</u> if telescope see back. (size)			
(5) screen <u>10'</u> <u>599'</u> (length) (depth to top) <u>2"</u> <u>S.S.</u> (size) (material)			
(6) pump <u>1</u> <u>8</u> (HP) (yield gpm) <u>Electric</u> (type power)			
(7) electric log <u>No</u> (yes or no) (organization running log)			
(8) how well bottom plugged <u>sand</u> <u>shrink</u>			
<b>DRILLERS REMARKS:</b>			
JAN 21 1971 MISS. DE. OF WATER CONTROL			

**CODED**

If well telescopes please sketch and show depths.

GROUND LEVEL

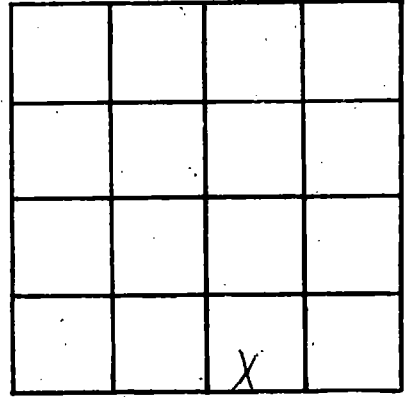

SECTION 16

Please indicate well location X.

ADDITIONAL INFORMATION

If more than one screen, show locations of each on sketch.