

F 97

M 518504

WATER WELL DRILLERS LOG

CODED

4-65

Date: Apr 1965, Driller: Joe Miller County Harrison

(Name)

(1) Owner of Land: Luther Patton
 (Name)
Gulfport Miss
 (Address)

(2) Location: 1/4, 1/4, Sec. 6 12, T. R,
 miles 10 ^{10' NW} of Gulfport,
 (distance) (direction) (Nearest Town)

(3) Topography: Hilly
 (Hilly) (Flat) (Level)

(4) Purpose of Well:
 (Domestic Irrigation
 Municipal, Industrial, Other)

Description & Color of Materials Sand, Clay, Red Clay, Shell, etc.	Thick- ness Feet	Depth Feet
Brown & White Clay	8	8
Cap Rock (Iron)	1	9
Wh Cl Pink Cl	25	34
Blue Clay	16	195
Gray Sd. (Fine)	16	232
Hard Blue Clay	63	295
Gray Sand (Fine)	11	306
" " (Fair)	11	317
" " (Fair)	15	332
Hard Blue Clay	5	337

Information upon completion of well:

(1) Diameter 2" inches.

(2) Total Depth 337' feet.

(3) Water Level 46' feet below top of ground.

(4) Cased to 322', Size 2"

(5) Screen: Size 2", Length 10'

(6) Were any formations sealed against pollution?
 _____ yes, _____ no.


6" Tail 11' 10"

CODED

If YES depth of formation _____

Why _____

Drillers Remarks: _____

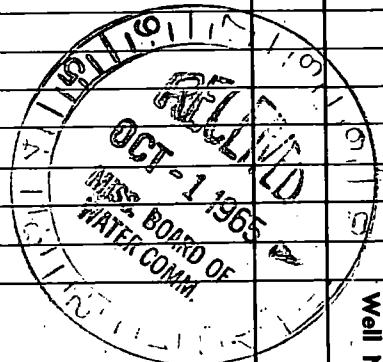

(Use Back Side)

Well No.

3000

H9 HKy

Author Pellen Place.

old HKy

St Swan A

Lymem

S3 HKy

