

HARRISON
F-106
8-16-71

MISSISSIPPI
 BOARD OF WATER COMMISSIONERS
 416 North State Street
 Jackson, Mississippi 39201

WATER WELL DRILLERS LOG

CODED

August 16 1971 M & B Drilling Co. Harrison
 date well completed firm name county well located

LANDOWNER: Foy Bennett
Windy Hills Ranch
P.O. Outpost Miss.
 (mailing address)

WELL LOCATION:
 sec. 18 T. 6 S. R. 12
1 miles S of Lizana
 (distance) (direction) (nearest town)

WELL PURPOSE: Feed Store
 (home, irrigation, municipal, industrial)

- WELL COMPLETION DATA:
- (1) diameter (inches) 2"
 - (2) total depth (feet) 560 (646)
 - (3) static water level (feet) 82 below top of ground.
 - (4) casing Galv. Steel, 646,
 (material) (depth)
2" if telescope see back.
 (size)
 - (5) screen 10 FT, 646
 (length) (depth to top)
2", S. Steel, 010
 (size) (material)
 - (6) pump 1 1/2, 10
 (HP) (yield gpm)
200 V 10 350 gpm Jet
 (type power)
 - (7) electric log No
 (yes or no)
- (organization running log)
- (8) how well bottom plugged:
2" Back Wash Check

description of formations encountered	from	to
Surface Soil	0	6
White & Red Clay	6	28
Brown Sand	28	30
White Clay	30	35
Blue Clay	35	48
White & Blue Clay	48	60
Blue Clay	60	105
Fine Grey Sand	105	128
Blue Clay	128	395
Fine Sand & Clay Bricks	395	465
Fine Grey Sand	465	480
Clay & Sand Bricks	480	570
Blue Clay	570	580
Coarse Grey Sand	580	580

Still cutting Sand at 560 FT

CODED

1971


MISS. BD. OF WATER COMMISSIONERS

DRILLERS REMARKS:

If well telescopes please sketch and show depths.

02100

GROUND LEVEL

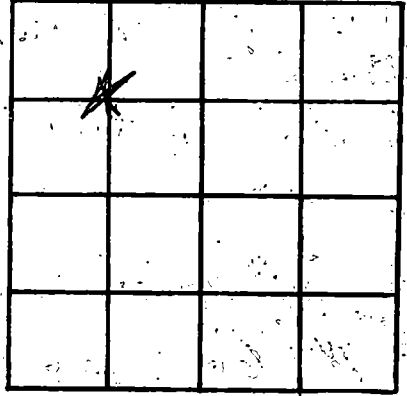

SECTION 18

Please indicate well location X.

ADDITIONAL INFORMATION

02100

If more than one screen, show locations of each on sketch.