

TPGF

HARRISON  
F114  
2-15-72

MISSISSIPPI  
BOARD OF WATER COMMISSIONERS  
416 North State Street  
Jackson, Mississippi 39201

**CODED**

WATER WELL DRILLERS LOG


2-15-72 19 R. J. Moore HARRISON  
date well completed firm name county well located

LANDOWNER: James DONN REI	description of formations encountered	from	to
Stuclere, MISS (mailing address)	TOP SOIL	0	10
	Red white clay	10	60
	White Sand	60	80
	Blue Clay	80	140
	RUSTY Sand	140	160
	Blue Clay	160	396
	GRAY Sand	396	420
WELL LOCATION:			
sec. 5 T. 6 N. R. 12 E.			
2 miles N of LIZIANA			
(distance) (direction) of (nearest town)			
WELL PURPOSE:			
(home, irrigation, municipal, industrial)			
WELL COMPLETION DATA:			
(1) diameter (inches) 2"			
(2) total depth (feet) 420'			
(3) static water level (feet) 23' below above top of ground.			
(4) casing 2 1/2" 410' (material) (depth)			
(size) if telescope see back.			
(5) screen 10' 410' (length) (depth to top)			
(size) SS (material)			
(6) pump 1 (HP) 8 (yield gpm)			
(type power)			
(7) electric log (yes or no)			
(organization running log)			
(8) how well bottom plugged 1/2" Blue			
DRILLERS REMARKS:			

**CODED**

If well telescopes please sketch and show depths.

**GROUND LEVEL**

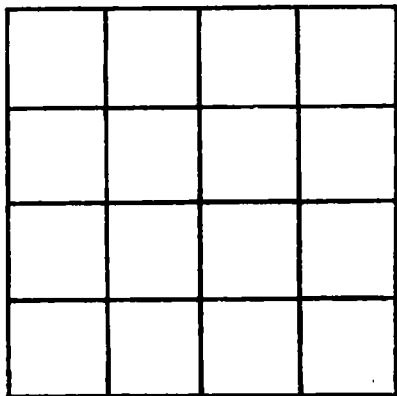

**SECTION** \_\_\_\_\_

**Please indicate well location X.**

**ADDITIONAL INFORMATION**

A series of 20 horizontal lines stacked vertically, providing space for handwritten additional information.

If more than one screen, show locations of each on sketch.