

HARRISON
F 120
5-29-72

MISSISSIPPI
 BOARD OF WATER COMMISSIONERS
 416 North State Street
 Jackson, Mississippi 39201
WATER WELL DRILLERS LOG

CODED

5-29 1972 Switzer Well Co. Harrison
 date well completed firm name county well located

LANDOWNER: Y. P. Milas
Rt. 2 Box 408
Gulfport, Miss.
 (mailing address)

WELL LOCATION:
 sec. 15 T. 6 S. R. 12 W.
12 miles North of Long Beach
 (distance) (direction) (nearest town)

WELL PURPOSE: Home
 (home, irrigation, municipal, industrial)

WELL COMPLETION DATA:

- (1) diameter (inches) 2"
- (2) total depth (feet) 363'
- (3) static water level (feet) 72' below top of ground above
- (4) casing galv. 363'
 (material) (depth)
 (size) if telescope see back.
- (5) screen 10' 353'
 (length) (depth to top)
008 stainless steel
 (size) (material)
- (6) pump 1 7.4
 (HP) (yield gpm)
Electric
 (type power)
- (7) electric log
 (yes or no)
 (organization running log)
- (8) how well bottom plugged Back
pressure valve

description of formations encountered	from to	
<u>(yellow) clay</u>	0	10
<u>red sand</u>	10	44
<u>red clay + gravel</u>	44	65
<u>clay</u>	65	72
<u>red sand</u>	72	79
<u>clay</u>	79	85
<u>blue clay</u>	85	116
<u>blue fine sand</u>	116	129
<u>fine sand</u>	129	150
<u>fine sand</u>	150	177
<u>blue clay</u>	177	198
<u>blue sand</u>	198	215
<u>fine sand</u>	215	225
<u>blue clay</u>	225	236
<u>soft clay</u>	236	257
<u>clay</u>	257	300
<u>clay - mixed</u>	300	305
<u>sand</u>	305	321
<u>clay - sand</u>	321	343
<u>sand</u>	343	363


CODED

10-23-81

DRILLERS REMARKS:

If well telescopes please sketch and show depths.

GROUND LEVEL

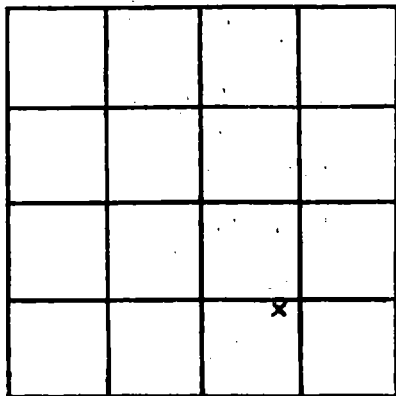

SECTION 15

Please indicate well location X.

ADDITIONAL INFORMATION

If more than one screen, show locations of each on sketch.