

CODED

HARRISON
F125
11-19-72

MISSISSIPPI
BOARD OF WATER COMMISSIONERS
416 North State Street
Jackson, Mississippi 39201

WATER WELL DRILLERS LOG

11-19 1972 M&B Drilling Co. Harrison
date well completed firm name county well located

LANDOWNER:	description of formations encountered	from	to
<u>Margaret Zimmerman</u>	<u>Surface</u>	<u>0</u>	<u>10</u>
<u>Box 1153 Gulfport, Miss.</u> (mailing address)	<u>Sand</u>	<u>10</u>	<u>25</u>
	<u>Blue Clay</u>	<u>25</u>	<u>90</u>
	<u>Fine Sand</u>	<u>90</u>	<u>115</u>
	<u>Sand & wood</u>	<u>115</u>	<u>120</u>
	<u>Blue Clay</u>	<u>120</u>	<u>240</u>
	<u>Fine Sand</u>	<u>240</u>	<u>245</u>
	<u>Sand & Clay Breaks</u>	<u>245</u>	<u>260</u>
	<u>Blue Clay</u>	<u>260</u>	<u>270</u>
	<u>Sand & Clay Breaks</u>	<u>270</u>	<u>330</u>
	<u>Fine Sand</u>	<u>330</u>	<u>390</u>
	<u>Blue Clay</u>	<u>390</u>	<u>600</u>
	<u>Ca...</u>	<u>600</u>	<u>660</u>
			<u>+</u>

CODED

DEC 11 1972

LANDOWNER:
Margaret Zimmerman
Box 1153 Gulfport, Miss.
(mailing address)

WELL LOCATION:
sec 2 T 6 S R 12 W
4 miles NW of Lyman
(distance) (direction) (nearest town)

WELL PURPOSE: Home
(home, irrigation, municipal, industrial)


- WELL COMPLETION DATA:
- (1) diameter (inches) 2"
 - (2) total depth (feet) 660
 - (3) static water level (feet) 2 below above top of ground.
 - (4) casing PVC Total
(material) (depth)
2"
(size) if telescope see back.
 - (5) screen 10 FT 640
(length) (depth to top)
2" .008 PVC
(size) (material)
 - (6) pump 1 15
(HP) (yield gpm)
220V 1P
(type power)
 - (7) electric log No
(yes or no)
- (organization running log)

(8) how well bottom plugged
2" Backwash Valve

DRILLERS REMARKS:

If well telescopes please sketch and show depths.

GROUND LEVEL

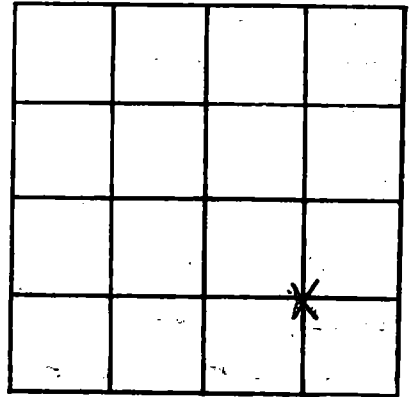

SECTION 2

Please indicate well location X.

ADDITIONAL INFORMATION

If more than one screen, show locations of each on sketch.