

HARRISON
F 126
12-8-72

MISSISSIPPI
 BOARD OF WATER COMMISSIONERS
 416 North State Street
 Jackson, Mississippi 39201

CODED

WATER WELL DRILLERS LOG

12-8 1972 Switzer Udale Company Harrison
 date well completed firm name county well located

LANDOWNER: <u>Royce Padriev</u>	description of formations encountered	from	to
		0	5
		5	20
		20	40
(mailing address)		40	60
		60	80
WELL LOCATION:		80	100
sec. <u>24</u> T. <u>6</u> S. R. <u>12</u> E. W.		100	120
<u>9 1/2</u> miles <u>NW</u> of <u>Gpt.</u>		120	128
(distance) (direction) (nearest town)		128	140
WELL PURPOSE: <u>home</u>		140	160
(home, irrigation, municipal, industrial)		160	174
WELL COMPLETION DATA:		174	179
(1) diameter (inches) <u>2</u>		179	194
(2) total depth (feet) <u>452'</u>		194	199
(3) static water level (feet) <u>81</u> <u>below</u> top of ground.		199	219
(4) casing <u>galv.</u> , <u>452'</u> (material) (depth)		219	229
<u>4</u> (size) if telescope see back.		229	259
(5) screen <u>20'</u> , <u>432'</u> (length) (depth to top)		259	292
<u>008</u> , <u>Stainless Steel</u> (size) (material)		292	307
(6) pump <u>3/4</u> (HP) <u>1 1/2</u> (yield gpm)		307	318
<u>ELECT</u> (type power)		318	333
(7) electric log <u>No</u> (yes or no)		333	347
(organization running log)		347	352
(8) how well bottom plugged <u>back</u>		352	368
<u>pressure valve</u>		368	421
DRILLERS REMARKS:		421	452

CODED

DEC 28 1972

If well telescopes please sketch and show depths.

GROUND LEVEL

147'


4" GALV.

2" GALV.

432'

452'

2" STAINLESS
STEEL WIRE
WRAPPED
WELL SCREEN

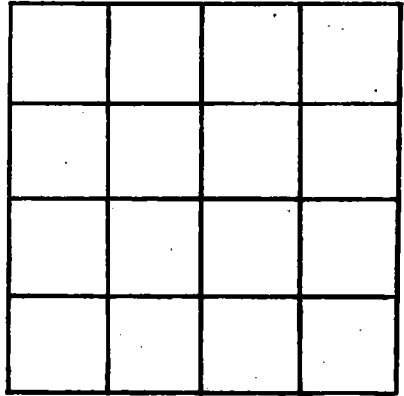

SECTION _____

Please indicate well location X.

ADDITIONAL INFORMATION

If more than one screen, show locations of each on sketch.