

HARRISON
F427
7-72

MISSISSIPPI
 BOARD OF WATER COMMISSIONERS
 416 North State Street
 Jackson, Mississippi 39201

CODED

WATER WELL DRILLERS LOG

July 1972 McHill Well Works Harrison
 date well completed firm name county well located

LANDOWNER: Frank Meltzer

description of formations encountered from to

Sauvier, Miss.

top soil 0 4

(mailing address)

clay 4 20

WELL LOCATION:

sec. 5 T. 6 N. R. 12 E
^S
^W
8 miles NE of Lawrence
 (distance) (direction) (nearest town)

sand 20 64

WELL PURPOSE: Home
 (home, irrigation, municipal, industrial)

clay 64 87

WELL COMPLETION DATA:

(1) diameter (inches) 2"
 (2) total depth (feet) 140'

(3) static water level (feet) 46' below top of ground.
120' above

(4) casing gal. 120'
 (material) (depth)

CODED

(size) if telescope see back.

(5) screen 20' 20'
 (length) (depth to top)

2" plastic
 (size) (material)

(6) pump 1/2 12
 (HP) (yield gpm)

Electric
 (type power)

(7) electric log no
 (yes or no)

(organization running log)

(8) how well bottom plugged sand
shark


APR 20 1973
 APR 20 1973

DRILLERS REMARKS:

MISS. BD. OF
 WATER COMM.

If well telescopes please sketch and show depths.

GROUND LEVEL

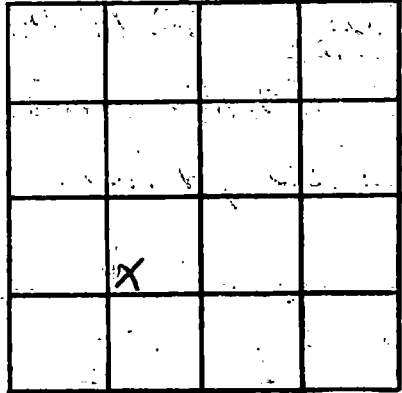

SECTION 5

Please indicate well location X.

ADDITIONAL INFORMATION

If more than one screen, show locations of each on sketch.