

HARRISON
F/28
5-20-72

MISSISSIPPI
 BOARD OF WATER COMMISSIONERS
 416 North State Street
 Jackson, Mississippi 39201

CODED

WATER WELL DRILLERS LOG

May 20 1972 Mc Gill Well Works Harrison
 date well completed firm name county well located

LANDOWNER: Allen Reel

description of formations encountered

from to

RE. I, Box 115-N

topsoil

0 3

Gulfport, Miss.
 (mailing address)

clay

3 140

WELL LOCATION:

sec. 8 T. 6 N. R. 12 E.
6 miles E of Lopiana
 (distance) (direction) (nearest town)

fine sand

140 156

fine sand

156 210

WELL PURPOSE: Home
 (home, irrigation, municipal, industrial)

coarse sand

210 280

WELL COMPLETION DATA:

- (1) diameter (inches) 2"
 (2) total depth (feet) 280'
 (3) static water level (feet) 60' below / above top of ground
 (4) casing plastic 270'
 (material) (depth)

- (size) if telescope see back.

- (5) screen 10' 10'
 (length) (depth to top)

2" plastic
 (size) (material)

- (6) pump 1 6
 (HP) (yield gpm)

electric
 (type power)

- (7) electric log no
 (yes or no)

(organization running log)


- (8) how well bottom plugged sand
shank

CODED

DRILLERS REMARKS:

If well telescopes please sketch and show depths.

GROUND LEVEL

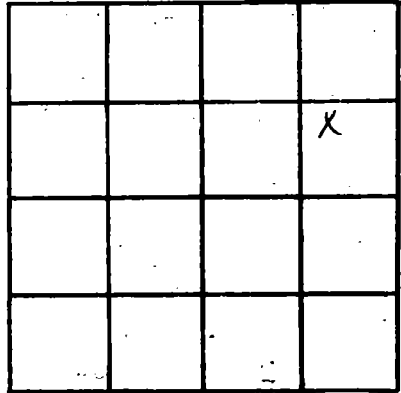

SECTION X

Please indicate well location X.

ADDITIONAL INFORMATION

If more than one screen, show locations of each on sketch.