

HARRISON
F 129
8-10-72

MISSISSIPPI
BOARD OF WATER COMMISSIONERS
416 North State Street
Jackson, Mississippi 39201
WATER WELL DRILLERS LOG

CODED

Aug. 10 1972 McBride Well Works Harrison
date well completed firm name county well located

LANDOWNER:

Amelia Heights
Sulfur Miss
(mailing address)

WELL LOCATION:

sec. 12 T. 6 N R. 12 E
 3 miles E of Loyanna
(distance) (direction) (nearest town)

WELL PURPOSE: Dom.
(home, irrigation, municipal, industrial)

WELL COMPLETION DATA:

- (1) diameter (inches) 2"
- (2) total depth (feet) 168'
- (3) static water level (feet) 53' below
top of ground. above
- (4) casing gal, 158'
(material) (depth)
- (size) if telescope see back.
- (5) screen 10',
(length) (depth to top)
2", plastic
(size) (material)
- (6) pump 1 7
(HP) (yield gpm)
electric
(type power)
- (7) electric log no
(yes or no)
-
(organization running log)

(8) how well bottom plugged sand
shark

DRILLERS REMARKS:

description of formations encountered

from to

Clay

0 42

Course Sand

42 96

Clay

96 141


Course Sand 141 168

CODED

McBride

If well telescopes please sketch and show depths.

GROUND LEVEL

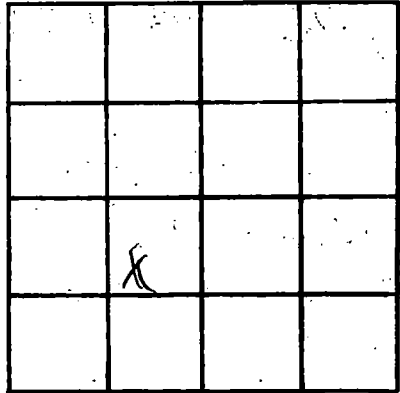

SECTION 17

Please indicate well location X.

ADDITIONAL INFORMATION

If more than one screen, show locations of each on sketch.