

HARRISON
F 130
9-1-70

MISSISSIPPI
 BOARD OF WATER COMMISSIONERS
 416 North State Street
 Jackson, Mississippi 39201
WATER WELL DRILLERS LOG

CODED

Sept. 1 1970 *Mc Hill Well Works* *Harrison*
 date well completed firm name county well located

LANDOWNER: *Curtis Cook*
Rt. 2, Box 95
Greifport Miss.
 (mailing address)

WELL LOCATION:
 sec. 24 T. 6 N. R. 12 E
 S. W.
6 miles W of Lyman
 (distance) (direction) (nearest town)

WELL PURPOSE: *Home*
 (home, irrigation, municipal, industrial)

- WELL COMPLETION DATA:
- (1) diameter (inches) 2"
 - (2) total depth (feet) 609'
 - (3) static water level (feet) 27' below above top of ground.
 - (4) casing gal. 599'
 (material) (depth)
 (size) if telescope see back.
 - (5) screen 10' -
 (length) (depth to top)
2" S.S.
 (size) (material)
 - (6) pump 1 8
 (HP) (yield gpm)
electric
 (type power)
 - (7) electric log No
 (yes or no)
 (organization running log)
 - (8) how well bottom plugged Sand
shark


description of formations encountered	from	to
<i>Topsoil</i>	<i>0</i>	<i>4</i>
<i>clay</i>	<i>4</i>	<i>168</i>
<i>fine sand</i>	<i>168</i>	<i>236</i>
<i>slush</i>	<i>236</i>	<i>272</i>
<i>clay</i>	<i>272</i>	<i>305</i>
<i>fine sand</i>	<i>305</i>	<i>386</i>
<i>clay</i>	<i>386</i>	<i>408</i>
<i>fine sand</i>	<i>408</i>	<i>427</i>
<i>clay</i>	<i>427</i>	<i>581</i>
<i>course sand</i>	<i>581</i>	<i>609</i>

CODED

DRILLERS REMARKS: JAN 29 1975

If well telescopes please sketch and show depths.

GROUND LEVEL

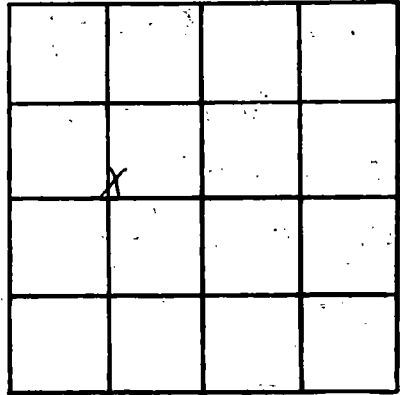

SECTION 24

Please indicate well location X.

ADDITIONAL INFORMATION

If more than one screen, show locations of each on sketch.