



If well telescopes please sketch and show depths.

GROUND LEVEL

4" Colvin

147 FT

2" Colvin


545 FT

2" x 10 FT

S.S. 008' down

555 FT

2" BWT Valve

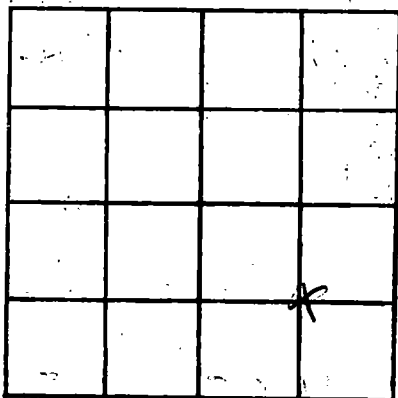

SECTION 20

Please indicate well location X.

ADDITIONAL INFORMATION

If more than one screen, show locations of each on sketch.