

HARRISON
F133
3-12-73

MISSISSIPPI
 BOARD OF WATER COMMISSIONERS
 416 North State Street
 Jackson, Mississippi 39201

CODE

WATER WELL DRILLERS LOG

3-12 1973 R. J. Moore HARRISON
 date well completed firm name county well located

LANDOWNER: WALTON LADNER
RT #1 Stackers, MISS
 (mailing address)
 WELL LOCATION:
 sec. 2 T. 6 N. R. 12 E.
2 1/2 miles W of Waltham
 (distance) (direction) (nearest town)

description of formations encountered	from	to
TOP SOIL	0	10
White Sand	10	20
White + Red Clay	20	70
Sand + Gravel	70	90
Blue Clay	90	280
Coarse Green Sand	280	305

WELL PURPOSE:
 (home, irrigation, municipal, industrial)

WELL COMPLETION DATA:
 (1) diameter (inches) 2"
 (2) total depth (feet) 305'
 (3) static water level (feet) 16' below above top of ground.
 (4) casing 9ALV, 294'
 (material) (depth)
 (size) if telescope see back.
 (5) screen 10', 294'
 (length) (depth to top)
2", 25
 (size) (material)
 (6) pump 1, 12
 (HP) (yield gpm)
E
 (type power)
 (7) electric log
 (yes or no)

 (organization running log)
 (8) how well bottom plugged 13W
with the




APR 20 1973

DRILLERS REMARKS:

If well telescopes please sketch and show depths.

GROUND LEVEL

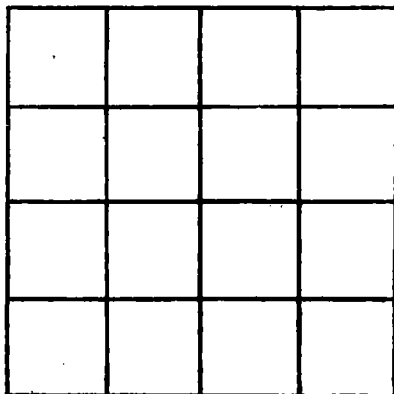

SECTION _____

Please indicate well location X.

ADDITIONAL INFORMATION

If more than one screen, show locations of each on sketch.