

**CODED**

MISSISSIPPI  
BOARD OF WATER COMMISSIONER  
416 North State Street  
Jackson, Mississippi 39201

**WATER WELL DRILLERS LOG**

**HARRISON**  
**F134**  
**3-29-73**

3-29 1973 Switzer Mole Company Harrison  
date well completed firm name county well located

LANDOWNER: Jim Switzer

description of formations encountered

from

to

clay	0	108
clay-sand sh.	108	129
clay	129	154
fine sand	154	173
fair sand	173	194
good sand	194	252
clay	252	258
clay-sand sh.	258	279
clay	279	319
fine sand	319	342
good sand	342	387
clay	387	403
fine sand	403	406
clay	406	424
fine sand	424	431
clay	431	482
clay-sand sh.	482	503
clay	503	517
good sand	517	552

(mailing address)

**WELL LOCATION:**

sec. 19 T. 6 S. R. 12 W.  
13 miles N of Long Beach  
(distance) (direction) (nearest town)

**WELL PURPOSE:** home  
(home, irrigation, municipal, industrial)

**WELL COMPLETION DATA:**

- (1) diameter (inches) 2
- (2) total depth (feet) 552'
- (3) static water level (feet) 81 <sup>(below)</sup> ~~above~~ top of ground.
- (4) casing galv. (material), 552' (depth)
- 4 (size) if telescope see back.
- (5) screen 20 (length), 532' (depth to top)
- 008 (size), Stainless Steel (material)
- (6) pump 1 (HP), 19 (yield gpm)
- electric (type power)
- (7) electric log no (yes or no)
- (organization running log)



(8) how well bottom plugged back  
Pressure Valve

DRILLERS REMARKS:

**APR 2 1973**

If well telescopes please sketch and show depths.

GROUND LEVEL

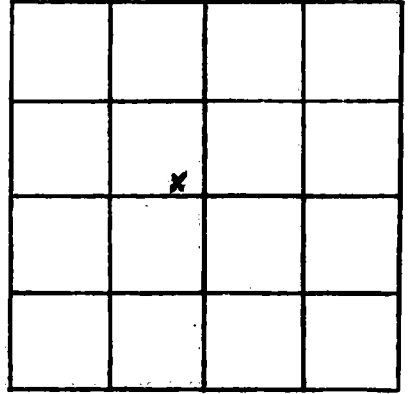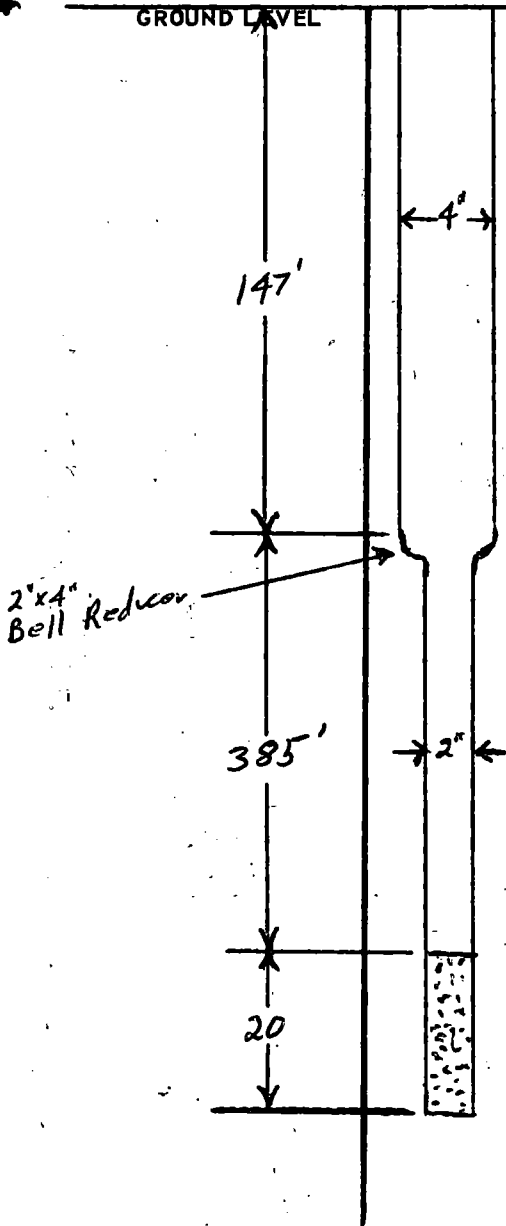

SECTION 19

Please indicate well location X.

ADDITIONAL INFORMATION

If more than one screen, show locations of each on sketch.