

Harrison
F139
4-16-73

MISSISSIPPI
BOARD OF WATER COMMISSIONERS
416 North State Street
Jackson, Mississippi 39201

CODED

WATER WELL DRILLERS LOG

April 16 1973 McNeil well works Harrison
date well completed firm name county well located

LANDOWNER: Leona Curran
Rt. 2 Box 242
Hartport Miss.
(mailing address)

| description of formations encountered | from | to |
|---------------------------------------|--------|--------|
| Clay | 0 | 18 |
| Sand | 18 | 47 |
| Bed Rock | 47 | 47 1/2 |
| Gravel | 47 1/2 | 51 |
| Clay | 51 | 122 |
| Council Sand | 122 | 189 |

WELL LOCATION:
sec. 18 T. 6 N. R. 12 E
14 miles SW of Lyman
(distance) (direction) (nearest town)

WELL PURPOSE: Home
(home, irrigation, municipal, industrial)

WELL COMPLETION DATA:

- (1) diameter (inches) 2"
- (2) total depth (feet) 189'
- (3) static water level (feet) 52' below top of ground
- (4) casing ~~steel~~ plastic 179' (material) (depth)

CODED

(size) If telescope see back.

- (5) screen 10' (length) (depth to top)

2" (size) plastic (material)

- (6) pump 1 (HP) 9 (yield gpm)

electric (type power)

- (7) electric log no (yes or no)

(organization running log)


- (8) how well bottom plugged sand shark

DRILLERS REMARKS:

SEP 10 1973

If well telescopes please sketch and show depths.

GROUND LEVEL

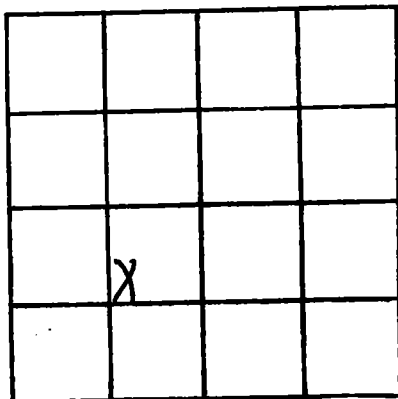

SECTION 18

Please indicate well location X.

ADDITIONAL INFORMATION

If more than one screen, show locations of each on sketch.