

MISSISSIPPI
BOARD OF WATER COMMISSIONERS
416 North State Street
Jackson, Mississippi 39201

WATER WELL DRILLERS LOG

CODED

Harrison
F141
7-28-73

July 28-73 19 19 R. J. Moore HARRISON
date well completed firm name county well located

LANDOWNER: Tom OUBORN
4160-28th Col Sport

description of formations encountered	from	to
TOP SOIL	0	10
Red Clay Shell	10	30
Red & white Clay	30	90
Red Shell	90	100
Blue Clay	100	180
Red Shell	180	200
Blue Clay	200	320
Red Shell	320	350

(mailing address)

WELL LOCATION:
sec. 30 T. 6 N. R. 12 E
2 miles S of LIZINA
(distance) (direction) (nearest town)

WELL PURPOSE:
(home, irrigation, municipal, industrial)

WELL COMPLETION DATA:

(1) diameter (inches) 2"

(2) total depth (feet) 300'

(3) static water level (feet) 35' below above top of ground.

(4) casing Galv 340'
(material) (depth)
(size) If telescope see back.

(5) screen 10' 340'
(length) (depth to top)
1/2" 95
(size) (material)

(6) pump 1 10
(HP) (yield gpm)
8
(type power)

(7) electric log
(yes or no)

(organization running log)

(8) how well bottom plugged


CODED

1973

DRILLERS REMARKS:

If well telescopes please sketch and show depths.

GROUND LEVEL

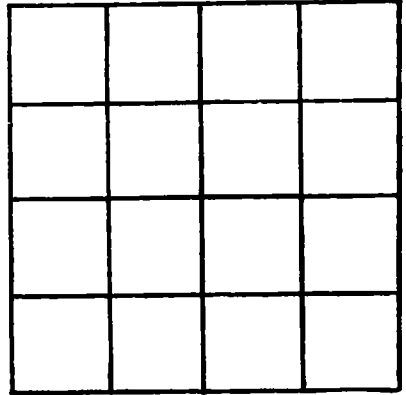

SECTION _____

Please indicate well location X.

ADDITIONAL INFORMATION

If more than one screen, show locations of each on sketch.