

MISSISSIPPI  
 BOARD OF WATER COMMISSIONERS  
 416 North State Street  
 Jackson, Mississippi 39201

**CODED**

**WATER WELL DRILLERS LOG**

Harrison  
F 145  
7-10-73

7-10-73 19 Sutter Well Works Harrison  
 date well completed firm name county well located

LANDOWNER: <u>R. W. Nicaise, Jr.</u> <u>210 Nicaise Ave.-</u> <u>Bay St. Louis, Miss.</u> (mailing address)	description of formations encountered	from	to
	Clay	0	16
	Sand	16	54
	Clay	54	152
	Sand	152	198
	Clay	198	220
	Sand	220	255
WELL LOCATION: <u>sec. 15 T. 6 S. R. 12 E.</u> <u>5 miles W of Lymon</u> (distance) (direction) (nearest town)			
WELL PURPOSE: <u>home</u> (home, irrigation, municipal, industrial)			
WELL COMPLETION DATA: (1) diameter (inches) <u>4"</u> (2) total depth (feet) <u>255'</u> (3) static water level (feet) <u>83'</u> below top of ground (4) casing <u>3" galv. top</u> (material) <u>245'</u> (depth) <u>4"</u> (size) if telescope see back. (5) screen <u>10'</u> (length) <u>245'</u> (depth to top) <u>4"</u> (size) <u>stainless steel</u> (material) (6) pump <u>3</u> (HP) <u>50</u> (yield gpm) <u>elec.</u> (type power) (7) electric log <u>no</u> (yes or no) (organization running log) (8) how well bottom plugged <u>B.P. Valve</u>			
DRILLERS REMARKS:			


**CODED**

SEP 5 1973

MISSISSIPPI  
 WATER COMMISSION

If well telescopes please sketch and show depths.

GROUND LEVEL

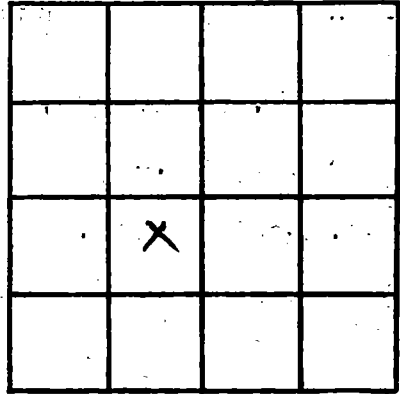

SECTION 15

Please indicate well location X.

ADDITIONAL INFORMATION

If more than one screen, show locations of each on sketch.