

273' of 4"

Harrison  
F151

3-18-74

Elwg# 105

MISSISSIPPI  
BOARD OF WATER COMMISSIONERS  
416 North State Street  
Jackson, Mississippi 39201

CODED

MAR 29 1974

WATER WELL DRILLERS LOG

3-18 1974 Switzer Well Co.  
date well completed firm nameHarrison  
county well locatedLANDOWNER Bedar Lake Egg Farm

Hwy 53

Gulfport, Miss

(mailing address)

## WELL LOCATION:

sec 16 T 6 S R 12 W  
10 miles NW of Gulfport  
(distance) (direction) (nearest town)WELL PURPOSE: Industrial  
(home, irrigation, municipal, industrial)

## WELL COMPLETION DATA:

- (1) diameter (inches) 3"
- (2) total depth (feet) 881 ft.
- (3) static water level (feet) 86 below  
top of ground. above
- (4) casing galv. 881  
(material) (depth)  
4"  
(size) If telescope see back.
- (5) screen 40 841  
(length) (depth to top)  
008 stainless steel  
(size) (material)
- (6) pump 2  
(HP) (yield gpm)

(type power)

- (7) electric log Yes  
(yes or no)

U.S. Geological Survey  
(organization running log)

- (8) how well bottom plugged hard  
pressure valve

DRILLERS REMARKS:

description of formations  
encountered

from

to

clay

0

98

sand

98

101

clay

101

145

fine sand

145

200

good sand

200

209

clay

209

326

rock

326

358

shale, rock

358

378

rock

378

388

clay

388

418

clay / sand str.

418

438

sand

438

443

clay

443

497

clay / sand str.

497

537

clay

537

554

sand

554

558

clay

558

595

good sand

595

617

clay / sand str.

617

637

clay

637

645

sand

645

647

clay

647

657

clay / sand str.

657

676

clay

676

696

shale

696

716

clay / shale

716

737

hard clay

737

776

clay

776

798

clay / hard rock

798

819

clay

819

828

sand

828

834

sand, fine

834

895

sand

895

916


clay

916


918

Well Set at 881 feet.

If well telescopes please sketch and show depths.

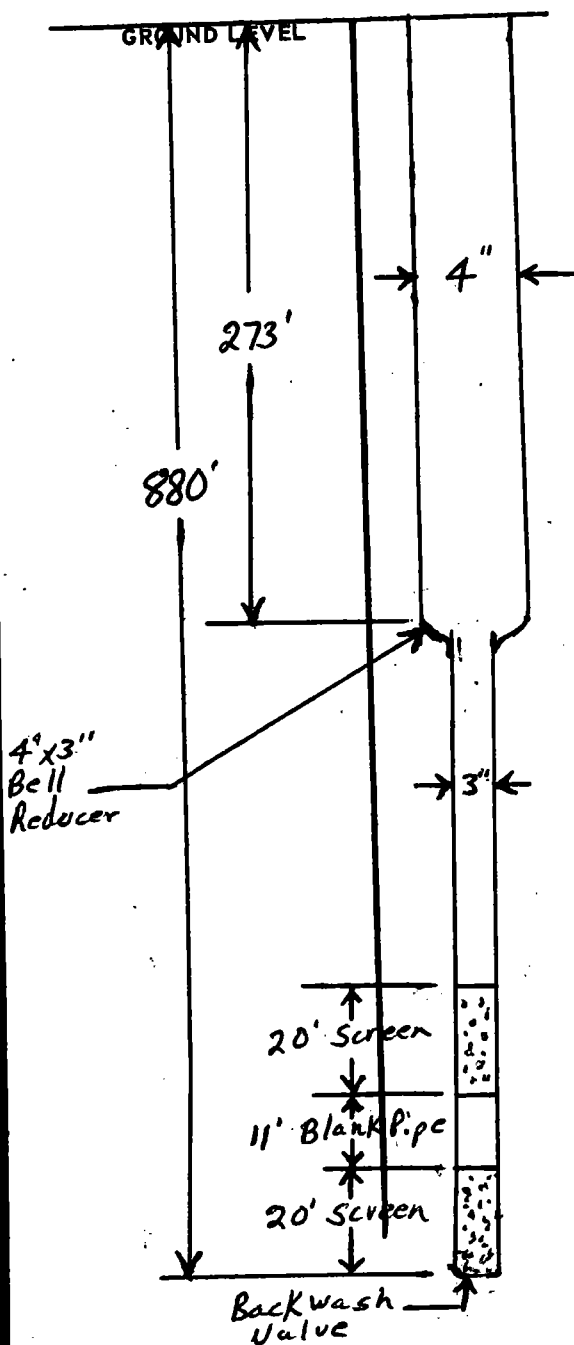

If more than one screen, show locations of each on sketch.

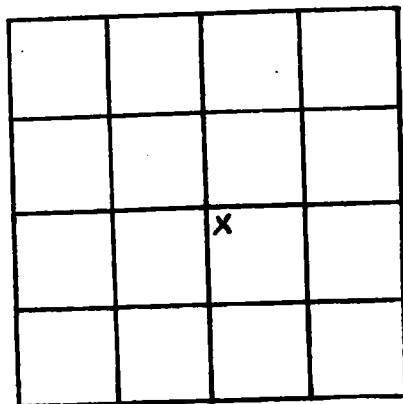

SECTION 16

Please indicate well location X.

ADDITIONAL INFORMATION