

HARRISON
F 152
1-17-74

MISSISSIPPI
 BOARD OF WATER COMMISSIONERS
 416 North State Street
 Jackson, Mississippi 39201
WATER WELL DRILLERS LOG

1-17-74 19 R. J. Moore HARRISON
 date well completed firm name county well located

LANDOWNER: A. TRIPPETT
 Hwy 53 LIZIANN
 Rt 1 Sucker MISS
 (mailing address)

description of formations encountered	from	to
Top Soil	0	10
Red Clay	10	60
Rusty Sand	60	80
White Sand Clay	80	100
Blue Clay	100	200
Fine Blue Sand	200	220
Blue Clay	220	270
Fine Grains Sand	270	310
Coarse Grains Sand	310	360

WELL LOCATION:
 sec. 8 T 6 N R 12 E
 (distance) (direction) (nearest town)
LIZIANN IN

WELL PURPOSE:
 Home, Irrigation, municipal, Industrial

WELL COMPLETION DATA:

(1) diameter (inches) 2"

(2) total depth (feet) 360'

(3) static water level (feet) 80' below above top of ground.

(4) casing PVC 350'
 (material) (depth)
 (size) If telescope see back.

(5) screen 10' 350'
 (length) (depth to top)
2" PVC
 (size) (material)

(6) pump 1 6
 (HP) (yield gpm)
8
 (type power)

(7) electric log (yes or no)
 (organization running log)

(8) how well bottom plugged 13 W 11 Plus


CODED

DRILLERS REMARKS:

MISS. 1974

If well telescopes please sketch and show depths.

GROUND LEVEL

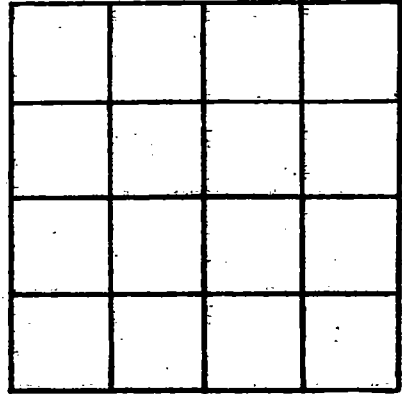

SECTION _____

Please indicate well location X.

ADDITIONAL INFORMATION

If more than one screen, show locations of each on sketch.