

**HARRISON**  
**F 53**  
**2-23-74**

MISSISSIPPI  
 BOARD OF WATER COMMISSIONERS  
 416 North State Street  
 Jackson, Mississippi 39201

**CODED**

**WATER WELL DRILLERS LOG**

2-23-74 19  
 date well completed

R. J. Moore  
 firm name


HARRISON  
 county well located

LANDOWNER: <u>Billy Smith</u>	description of formations encountered	from	to
<u>Box 423 H</u>	<u>TOP SOIL</u>	<u>0</u>	<u>10</u>
<u>Gulfport, Miss</u> (mailing address)	<u>Red + white Clay</u>	<u>10</u>	<u>20</u>
WELL LOCATION: sec <u>25</u> T <u>6</u> N R <u>12</u> E <u>2 1/2</u> miles <u>W</u> of <u>Nusent</u> (distance) (direction) (nearest town)	<u>Gray Clay</u>	<u>20</u>	<u>100</u>
WELL PURPOSE: (home irrigation, municipal, industrial)	<u>RESTY Sand</u>	<u>100</u>	<u>170</u>
WELL COMPLETION DATA:	<u>Blue Clay</u>	<u>170</u>	<u>340</u>
(1) diameter (inches) <u>2"</u>	<u>FINE Sand</u>	<u>340</u>	<u>350</u>
(2) total depth (feet) <u>530'</u>	<u>Blue Clay</u>	<u>350</u>	<u>490</u>
(3) static water level (feet) <u>78'</u> <sup>below</sup> <sub>above</sub> top of ground.	<u>COARSE Clay Sand</u>	<u>490</u>	<u>530</u>
(4) casing <u>galv</u> <u>510'</u> (material) (depth)			
(5) screen <u>20'</u> <u>530'</u> (length) (depth to top)			
(6) pump <u>2"</u> <u>SS</u> (size) (material)			
(6) pump <u>1 1/2</u> <u>70</u> (HP) (yield gpm)			
(7) electric log <u>2</u> (type power)			
(7) electric log (yes or no)			
(8) how well bottom plugged			
<u>BW Water</u>			
DRILLERS REMARKS:			

**CODED**

**if well telescopes please  
sketch and show depths.**

**GROUND LEVEL**

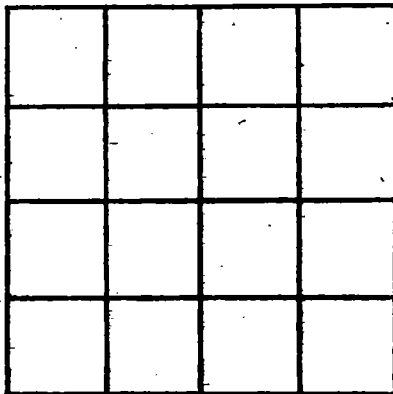

**SECTION \_\_\_\_\_**

**Please indicate well location X.**

**ADDITIONAL INFORMATION**

**If more than one screen,  
show locations of each on sketch.**