

**MISSISSIPPI  
BOARD OF WATER COMMISSIONERS**  
416 North State Street  
Jackson, Mississippi 39201

**WATER WELL DRILLERS LOG**

**F 155**  
**HARRISON**  
**8-15-73**

Aug. 15 19 73 McGill well works Harrison  
date well completed firm name county well located

LANDOWNER: W.R. Byrd.

description of formations encountered

from to

Rt. 2, Box 284

Hgt. Mo.  
(mailing address)

Blue clay 0 87  
fine sand 97 15

**WELL LOCATION:**

sec. 13 T 6 N R. 12 E  
3 miles South of Starm  
(distance) (direction) (nearest town)

WELL PURPOSE: home  
(home, irrigation, municipal, industrial)

**WELL COMPLETION DATA:**

- (1) diameter (inches) 2"
- (2) total depth (feet) 115'
- (3) static water level (feet) 22' below above top of ground.
- (4) casing plastic 105'  
(material) (depth)

**CODED**

— if telescope see back.  
(size)

- (5) screen 10' —  
(length) (depth to top)

2" plastic  
(size) (material)

- (6) pump 1/2 3  
(HP) (yield gpm)

electric  
(type power)

- (7) electric log no  
(yes or no)

—  
(organization running log)


- (8) how well bottom plugged sand  
stone

DRILLERS REMARKS:

MISS. BOARD OF WATER COMMISSIONERS

If well telescopes please sketch and show depths.

GROUND LEVEL

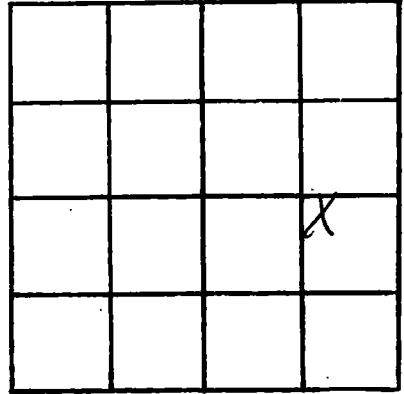

SECTION 13

Please indicate well location X.

ADDITIONAL INFORMATION

If more than one screen, show locations of each on sketch.