

F 156
 HARRISON
 4-12-74

MISSISSIPPI
 BOARD OF WATER COMMISSIONERS
 416 North State Street
 Jackson, Mississippi 39201

WATER WELL DRILLERS LOG


11-12-74 19 R. J. Mackee HARRISON
 date well completed firm name county well located

LANDOWNER <u>George GRANK</u> <u>RT 2 Box 380</u>	description of formations encountered	from	to
<u>GULSPORT, MISS</u> (mailing address)	<u>TOPSOIL</u>	<u>0</u>	<u>10</u>
WELL LOCATION: sec. <u>22</u> T <u>6</u> N R. <u>12</u> E <u>5</u> miles <u>W</u> of <u>LYNN</u> (distance) (direction) (nearest town)	<u>Red Clay</u>	<u>10</u>	<u>30</u>
WELL PURPOSE: (Home, Irrigation, municipal, Industrial)	<u>White Clay</u>	<u>30</u>	<u>20</u>
WELL COMPLETION DATA: (1) diameter (inches) <u>2"</u>	<u>Blue Clay</u>	<u>70</u>	<u>225</u>
(2) total depth (feet) <u>576'</u>	<u>GRAY SAND mud</u>	<u>280</u>	<u>300</u>
(3) static water level (feet) <u>90'</u> ^{below} above top of ground.	<u>Red Clay</u>	<u>300</u>	<u>560</u>
(4) casing <u>galv</u> <u>566'</u> (material) (depth)	<u>Coarse Gray Sand</u>	<u>566</u>	<u>576</u>
(5) screen <u>10'</u> <u>566'</u> (length) (depth to top)			
(6) pump <u>1 1/2</u> <u>6</u> (HP) (yield gpm)			
(7) electric log (yes or no)			
(8) how well bottom plugged			
DRILLERS REMARKS:			

CODED

If well telescopes please sketch and show depths.

GROUND LEVEL

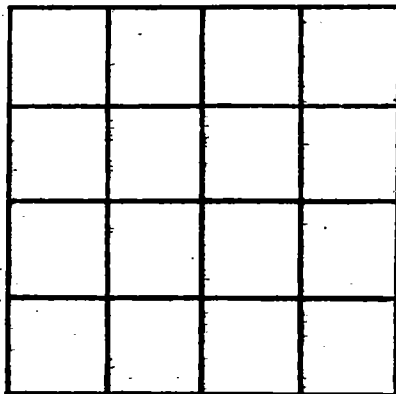

SECTION _____

Please indicate well location X.

ADDITIONAL INFORMATION

If more than one screen, show locations of each on sketch.