

HARRISON
 F 157
 7-13-73

MISSISSIPPI
 BOARD OF WATER COMMISSIONERS
 416 North State Street
 Jackson, Mississippi 39201

WATER WELL DRILLERS LOG

July 13 1973 H.A. Ladnier's Well Works HARRISON
 date well completed firm name county well located

LANDOWNER: Alfred Moreton
 LIZANA, Mississippi
 (mailing address)

description of formations encountered	from	to
Blue Sand	0	40
Red & Yellow Clay	40	120
Blue Clay	120	340

WELL LOCATION:
 sec. 4 T. 6 N R. 12 E
 S W
 0 miles 0 of LIZANA
 (distance) (direction) (nearest town)

according to this well
 set in clay ??

WELL PURPOSE: HOME
 (home, irrigation, municipal, industrial)

WELL COMPLETION DATA:
 (1) diameter (inches) 2 inch
 (2) total depth (feet) 340
 (3) static water level (feet) 40 below above top of ground.
 (4) casing GALV., 330.
 (material) (depth)
 2 inch (size) if telescope see back.
 (5) screen 10ft., 330ft.
 (length) (depth to top)
 2 inch, STAINLESS STEEL
 (size) (material)
 (6) pump 1 6
 (HP) (yield gpm)
 Electric
 (type power)
 (7) electric log NO
 (yes or no)

CODED

(organization running log)
 (8) how well bottom plugged Ball Check


DISCOVERED
 APR 30 1974

DRILLERS REMARKS:

MISS. BD. OF WATER COMMISSIONERS

If well telescopes please sketch and show depths.

GROUND LEVEL

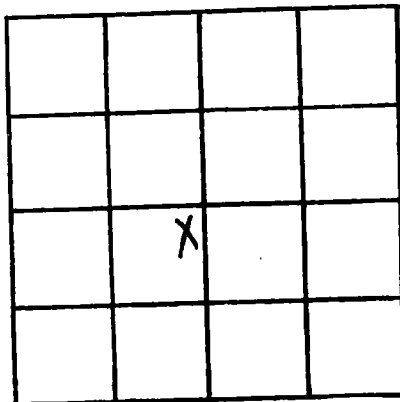

SECTION #4

Please indicate well location X.

ADDITIONAL INFORMATION

If more than one screen, show locations of each on sketch.