

HARRISON
F158
5-19-74

MISSISSIPPI
 BOARD OF WATER COMMISSIONERS
 416 North State Street
 Jackson, Mississippi 39201

CODED


WATER WELL DRILLERS LOG

5-14-74 19 R. J. Moore HARRISON
 date well completed firm name county well located

LANDOWNER: <u>R. O. HENDRY</u> <u>Box 424</u>	description of formations encountered	from	to
<u>Gulfport, MS</u> (mailing address)	<u>TOP SOIL</u>	<u>0</u>	<u>10</u>
WELL LOCATION: sec <u>25</u> T <u>6</u> N R <u>12</u> E <u>2 1/2</u> miles <u>W</u> of <u>Nescent</u> (distance) (direction) (nearest town)	<u>White + Blue Clay</u>	<u>10</u>	<u>60</u>
WELL PURPOSE: (home, irrigation, municipal, industrial)	<u>Blue Clay</u>	<u>60</u>	<u>200</u>
WELL COMPLETION DATA: (1) diameter (inches) <u>2"</u>	<u>rusty sand</u>	<u>200</u>	<u>220</u>
(2) total depth (feet) <u>520'</u>	<u>Blue GRADED</u>	<u>220</u>	<u>420</u>
(3) static water level (feet) <u>70'</u> <u>below</u> <u>above</u> top of ground.	<u>COARSE GRAY SAND</u>	<u>420</u>	<u>520</u>
(4) casing <u>galv</u> <u>510'</u> (material) (depth)			
(5) screen <u>10'</u> <u>510'</u> (length) (depth to top)			
(6) pump <u>8</u> <u>8</u> (HP) (yield gpm)			
(7) electric log <u>8</u> (yes or no)			
(8) how well bottom plugged <u>Blw 2 ft</u>			
DRILLERS REMARKS:			

If well telescopes please sketch and show depths.

GROUND LEVEL

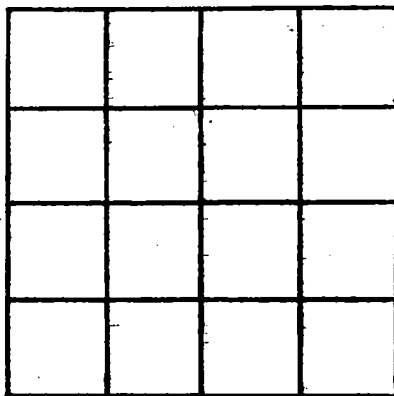

SECTION _____

Please indicate well location X.

ADDITIONAL INFORMATION

If more than one screen, show locations of each on sketch.