

HARRISON
F 161
6-27-74

MISSISSIPPI
 BOARD OF WATER COMMISSIONERS
 416 North State Street
 Jackson, Mississippi 39201

CODED

WATER WELL DRILLERS LOG

6-27-74 19
 date well completed

P. J. Moore
 firm name

HARRISON
 county well located


LANDOWNER: <u>F. W. FAHARD</u>	description of formations encountered	from	to
<u>1072 Road 422</u>			
<u>GULSPORT, MS</u> (mailing address)	<u>Red Sand</u>	<u>60</u>	<u>120</u>
WELL LOCATION:	<u>Clay</u>	<u>120</u>	<u>200</u>
sec <u>25</u> T <u>6</u> N R <u>12</u> E	<u>Red Sand</u>	<u>200</u>	<u>220</u>
<u>3</u> miles <u>E</u> of <u>LIZONA</u>	<u>Clay</u>	<u>220</u>	<u>485</u>
(distance) (direction) (nearest town)	<u>Grey Sand</u>	<u>485</u>	<u>520</u>
WELL PURPOSE: (home, irrigation, municipal, industrial)			
WELL COMPLETION DATA:			
(1) diameter (inches) <u>2"</u>			
(2) total depth (feet) <u>520'</u>			
(3) static water level (feet) <u>80'</u> ^{below} _{above} top of ground.			
(4) casing <u>galv</u> <u>500'</u> (material) (depth)			
(size) if telescope see back.			
(5) screen <u>20'</u> <u>500'</u> (length) (depth to top)			
<u>2"</u> <u>SS</u> (size) (material)			
(6) pump <u>1 1/2</u> <u>?</u> (HP) (yield gpm)			
<u>?</u> (type power)			
(7) electric log (yes or no)			
(organization running log)			
(8) how well bottom plugged <u>Partial</u>			
DRILLERS REMARKS:			

CODED

RECEIVED
 AUG 16 1974

If well telescopes please sketch and show depths.

GROUND LEVEL

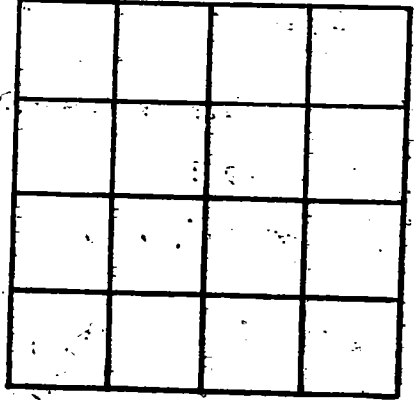

SECTION _____

Please indicate well location X.

ADDITIONAL INFORMATION

If more than one screen, show locations of each on sketch.