


HARRISON
 F162
 2-20-74

MISSISSIPPI
 BOARD OF WATER COMMISSIONERS
 416 North State Street
 Jackson, Mississippi 39201

CODED


WATER WELL DRILLERS LOG

2-20-74 19 R. T. Moore HARRISON
 date well completed firm name county well located

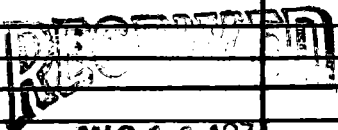LANDOWNER: <u>Robbie Trussle</u>	description of formations encountered	from	to
<u>Spacer, ms</u>	<u>TAP SOLE</u>	<u>0</u>	<u>60</u>
(mailing address)	<u>Red Sand</u>	<u>60</u>	<u>95</u>
WELL LOCATION: sec. <u>5</u> T. <u>6</u> N. R. <u>12</u> E. <u>W</u>	<u>Clay</u>	<u>95</u>	<u>265</u>
<u>2</u> miles <u>N</u> of <u>LIZIANA</u>	<u>SILT</u>	<u>265</u>	<u>275</u>
(distance) (direction) (nearest town)	<u>Clay</u>	<u>285</u>	<u>380</u>
WELL PURPOSE: (home, irrigation, municipal, industrial)	<u>Gray Sand</u>	<u>380</u>	<u>405</u>
WELL COMPLETION DATA: (1) diameter (inches) <u>2'</u>	CODED		
(2) total depth (feet) <u>405'</u>			
(3) static water level (feet) <u>227'</u> ^{below} _{above} top of ground.			
(4) casing <u>PVC</u> , <u>395'</u> (material) (depth)			
_____ if telescope see back. (size)			
(5) screen <u>10'</u> <u>395'</u> (length) (depth to top)			
<u>2"</u> <u>PVC</u> (size) (material)			
(6) pump <u>1</u> <u>10</u> (HP) (yield gpm) <u>8</u> (type power)			
(7) electric log _____ (yes or no) _____ (organization running log)			
(8) how well bottom plugged _____ <u>2 1/2" pipe</u>			
DRILLERS REMARKS: _____	 AUG 16 1974 MISS. BD. OF WATER COM.		

If well telescopes please sketch and show depths.

GROUND LEVEL

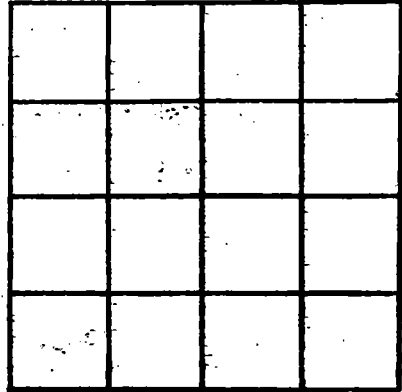

SECTION _____

Please indicate well location X.

ADDITIONAL INFORMATION

If more than one screen,
show locations of each on sketch.