

HARRISON
F/63
10/4/73

MISSISSIPPI
 BOARD OF WATER COMMISSIONERS
 416 North State Street
 Jackson, Mississippi 39201

CODED

WATER WELL DRILLERS LOG

October 4, 1973 W.A. Ladnier Well Works HARRISON
 date well completed firm name county well located

LANDOWNER: J. D. Parker
Poplarville Hwy. 53
Lizana, Miss.
 (mailing address)

description of formations encountered	from	to
	yellow clay	0
yellow sand	100	90
yellow clay	90	100
blue clay	100	400
blue sand	400	445

WELL LOCATION:
 sec. 4 T. 6 S. R. 12 W.
4 miles E of Lizana
 (distance) (direction) (nearest town)

WELL PURPOSE: HOME
 (home, irrigation, municipal, industrial)

- WELL COMPLETION DATA:
- (1) diameter (inches) 2 inch
 - (2) total depth (feet) 445 FT.
 - (3) static water level (feet) 75 below top of ground.
 - (4) casing Galv. 435
 (material) (depth)
2 inch if telescope see back.
 (size)
 - (5) screen 10 435
 (length) (depth to top)
2 inch, STAINLESS STEEL
 (size) (material)
 - (6) pump 1 9
 (HP) (yield gpm)
Electric
 (type power)
 - (7) electric log No
 (yes or no)

(organization running log)

(8) how well bottom plugged Ball Check


DRILLERS REMARKS:

REGISTERED
 NOV - 4 1974

MISS. BD. OF WATER COMM

If well telescopes please sketch and show depths.

GROUND LEVEL

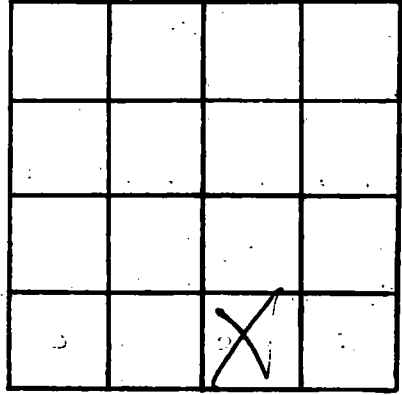

SECTION 4

Please indicate well location X.

ADDITIONAL INFORMATION

If more than one screen,
show locations of each on sketch.