

**Harrison**  
**F 164**  
**11-6-73**

MISSISSIPPI  
 BOARD OF WATER COMMISSIONERS  
 416 North State Street  
 Jackson, Mississippi 39201

**CODED**

**WATER WELL DRILLERS LOG**

November 6 1973 H.A. Hadwier Well Works Amite  
 date well completed firm name county well located


LANDOWNER:	description of formations encountered	from	to
<u>London</u>	<u>yellow clay</u>	<u>0</u>	<u>45</u>
<u>LIZANA, Miss.</u> (mailing address)	<u>yellow sand</u>	<u>45</u>	<u>70</u>
WELL LOCATION: sec. <u>4</u> T. <u>6</u> S. R. <u>12</u> <u>5</u> miles <u>SE</u> of <u>Lizana</u> (distance) (direction) (nearest town)	<u>yellow clay</u>	<u>70</u>	<u>110</u>
WELL PURPOSE: <u>HOME</u> (home, irrigation, municipal, industrial)	<u>blue clay</u>	<u>110</u>	<u>190</u>
WELL COMPLETION DATA: (1) diameter (inches) <u>2 inch</u>	<u>blue sand</u>	<u>190</u>	<u>210</u>
(2) total depth (feet) <u>210 FT.</u>			
(3) static water level (feet) <u>60</u> below top of ground.			
(4) casing <u>Galv.</u> , <u>200 ft.</u> (material) (depth)			
<u>2 inch</u> if telescope see back. (size)			
(5) screen <u>10 FT.</u> , <u>200 FT.</u> (length) (depth to top)			
<u>2 inch</u> , <u>STAINLESS STEEL</u> (size) (material)			
(6) pump <u>1</u> <u>10</u> (HP) (yield gpm)			
<u>Electric</u> (type power)			
(7) electric log <u>NO</u> (yes or no)			
(organization running log)			
(8) how well bottom plugged <u>Ball Check</u>			
DRILLERS REMARKS:			

REGISTRATION  
 NOV 4 1974

MISS. BD. OF WATER COMM.

If well telescopes please sketch and show depths.

GROUND LEVEL

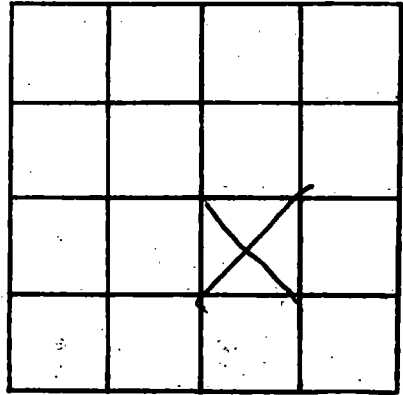

SECTION 4

Please indicate well location X.

ADDITIONAL INFORMATION

If more than one screen, show locations of each on sketch.