

Harrison
FL65
8-25-74

MISSISSIPPI
 BOARD OF WATER COMMISSIONERS
 416 North State Street
 Jackson, Mississippi 39201

CODEL

WATER WELL DRILLERS LOG


Aug 25 1974 Ladnier's Well Works Harrison
 date well completed firm name county well located

LANDOWNER: <u>Harold Lacey</u> <u>Gulf Haven Rd.</u> <u>Mennonite Settlement</u> (mailing address) <u>MS</u>	description of formations encountered	from	to
WELL LOCATION: sec. <u>4</u> T. <u>6</u> S. R. <u>12</u> W. <u>8</u> miles <u>SE</u> of <u>Lizana</u> (distance) (direction) (nearest town)			
WELL PURPOSE: <u>home</u> (home, irrigation, municipal, industrial)	<u>yellow sand</u>	<u>95</u>	<u>75</u>
WELL COMPLETION DATA: (1) diameter (inches) <u>2 inches</u>	<u>yellow clay</u>	<u>75</u>	<u>110</u>
(2) total depth (feet) <u>420 ft</u>	<u>blue clay</u>	<u>110</u>	<u>390</u>
(3) static water level (feet) _____ below/above top of ground	<u>blue sand</u>	<u>390</u>	<u>420</u>
(4) casing (material) <u>2"</u> (depth) <u>420</u>			
<u>2 inch</u> (size) if telescope see back.			
(5) screen (length) <u>10ft</u> (depth to top) <u>410ft</u>			
<u>2"</u> (size) <u>S.S. Steel</u> (material)			
(6) pump (HP) <u>1</u> (yield gpm) <u>8</u>			
<u>Electric</u> (type power)			
(7) electric log <u>No</u> (yes or no)			
(organization running log)			
(8) how well bottom plugged <u>ball check</u>			
DRILLERS REMARKS:			

RECEIVED
 AUG - 4 1974
 MISS. BOARD OF WATER COMM

If well telescopes please sketch and show depths.

GROUND LEVEL

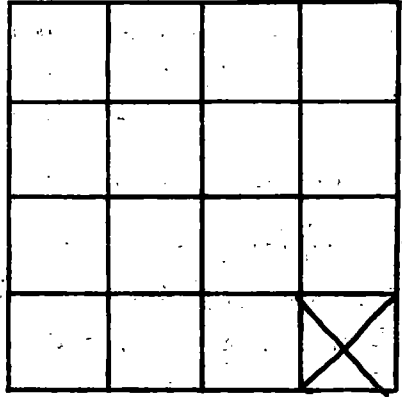

SECTION 4

Please indicate well location X.

ADDITIONAL INFORMATION

If more than one screen, show locations of each on sketch.