

Harrison
F 166
9-17-74

MISSISSIPPI
 BOARD OF WATER COMMISSIONERS
 416 North State Street
 Jackson, Mississippi 39201

CODED

WATER WELL DRILLERS LOG

Sept 17 1974
 date well completed

Ladniers Well Works
 firm name

Harrison
 county well located

LANDOWNER: <u>Bill Pickering</u> <u>Hulv Haven Rd.</u>	description of formations encountered	from	to
<u>Mennonite Settlement</u> (mailing address) <u>MS</u>	<u>yellow clay</u>	<u>0</u>	<u>80</u>
WELL LOCATION: sec. <u>4</u> T. <u>6</u> S. R. <u>12</u> E. <u>8</u> miles <u>SE</u> of <u>LIZANA</u> (distance) (direction) (nearest town)	<u>yellow sand</u>	<u>80</u>	<u>120</u>
WELL PURPOSE: <u>home</u> (home, irrigation, municipal, industrial)	<u>yellow clay</u>	<u>120</u>	<u>200</u>
WELL COMPLETION DATA: (1) diameter (inches) <u>2 in.</u>	<u>blue clay</u>	<u>200</u>	<u>245</u>
(2) total depth (feet) <u>735</u>	<u>blue sand</u>	<u>245</u>	<u>735</u>
(3) static water level (feet) <u>75</u> below top of ground.			
(4) casing <u>galv.</u> , <u>735</u> , (material) (depth) <u>2 in.</u> if telescope see back. (size)			
(5) screen <u>20ft</u> , <u>715</u> (length) (depth to top) <u>2 in.</u> , <u>S. steel</u> (size) (material)			
(6) pump <u>2</u> <u>9</u> (HP) (yield gpm) <u>elec.</u> (type power)			
(7) electric log <u>No</u> (yes or no)			
(8) how well bottom plugged <u>billcheck</u>			
DRILLERS REMARKS:			


RECEIVED

NOV - 4 1974

MISS. BD. OF WATER COMM

If well telescopes please sketch and show depths.

GROUND LEVEL

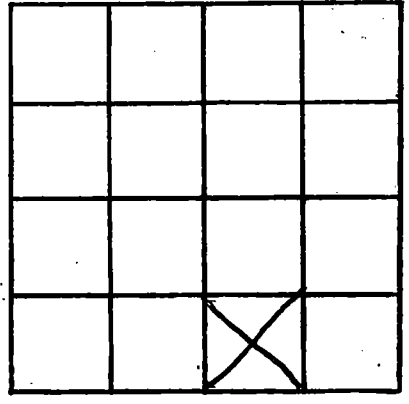

SECTION 4

Please indicate well location X.

ADDITIONAL INFORMATION

A series of horizontal lines for writing additional information.

If more than one screen, show locations of each on sketch.