

Harrison
F167
10-18-74
Oct.

MISSISSIPPI
BOARD OF WATER COMMISSIONERS CODED
416 North State Street
Jackson, Mississippi 39201


WATER WELL DRILLERS LOG

18 1974
date well completed

Ladnier's Well Works
firm name

Harrison
county well located

LANDOWNER:	description of formations encountered	from	to
ADAMS Houston Ladner Rd. Lizana, MS (mailing address)	yellow clay yellow sand yellow clay blue clay blue sand	0 95 105 150 420	45 105 150 470 470
WELL LOCATION: sec. 4 T. 6 S. R. 12 W. 4 miles NE of Lizana (distance) (direction) (nearest town)			
WELL PURPOSE: home (home, irrigation, municipal, industrial)			
WELL COMPLETION DATA: (1) diameter (Inches) 2 in. (2) total depth (feet) 480 ft. (3) static water level (feet) 26 below top of ground. (4) casing GALV. 470 ft. (material) (depth) 2 in. (size) If telescope see back. (5) screen 10 ft. 470 ft. (length) (depth to top) 2 in. S Steel (size) (material) (6) pump 1 7 (HP) (yield gpm) elec. (type power) (7) electric log No (yes or no) (organization running log) (8) how well bottom plugged ball check			
DRILLERS REMARKS:			

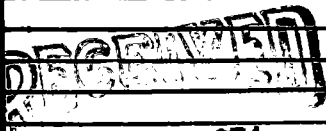


NOV - 4 1974

MISS. BD. OF WATER COMM.

If well telescopes please sketch and show depths.

GROUND LEVEL

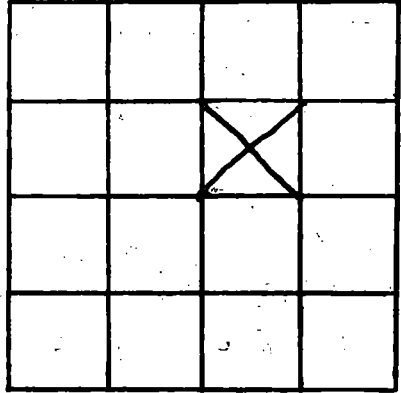

SECTION 4

Please indicate well location X.

ADDITIONAL INFORMATION

If more than one screen, show locations of each on sketch.