

Harrison
F168
7-26-73

MISSISSIPPI
 BOARD OF WATER COMMISSIONERS
 416 North State Street
 Jackson, Mississippi 39201

CODED
 100

WATER WELL DRILLERS LOG


July 26 1973 H.A. Ladwier's Wellworks firm name
 date well completed county well located

LANDOWNER: <u>T.D. McKay</u>	description of formations encountered	from	to
<u>Lizana, Miss.</u> (mailing address)	<u>yellow clay</u>	<u>0</u>	<u>40</u>
WELL LOCATION: sec. <u>4</u> T. <u>6</u> S. R. <u>12</u> W. <u>1 1/2</u> miles <u>SE</u> of <u>Lizana</u> (distance) (direction) (nearest town)	<u>yellow sand</u>	<u>40</u>	<u>90</u>
WELL PURPOSE: <u>HOME</u> (home, irrigation, municipal, industrial)	<u>yellow clay</u>	<u>90</u>	<u>110</u>
WELL COMPLETION DATA: (1) diameter (inches) <u>2 inch</u>	<u>blue clay</u>	<u>110</u>	<u>160</u>
(2) total depth (feet) <u>200 ft.</u>	<u>blue sand</u>	<u>160</u>	<u>200</u>
(3) static water level (feet) <u>45</u> ^{below} above top of ground.			
(4) casing <u>Galv.</u> , <u>190 ft.</u> (material) (depth) <u>2 inch</u> if telescope see back. (size)			
(5) screen <u>10 ft.</u> , <u>190 ft.</u> (length) (depth to top) <u>2 inch</u> , <u>STAINLESS STEEL</u> (size) (material)			
(6) pump <u>1</u> <u>7</u> (HP) (yield gpm) <u>elec.</u> (type power)			
(7) electric log <u>NO</u> (yes or no)			
(8) how well bottom plugged <u>Ball Check</u>			
DRILLERS REMARKS:			

RECEIVED
 NOV - 4 1974

If well telescopes please sketch and show depths.

GROUND LEVEL

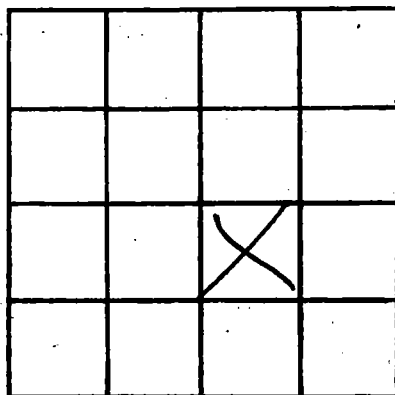

SECTION

4

Please indicate well location X.

ADDITIONAL INFORMATION

If more than one screen, show locations of each on sketch.