

Harrison
F169
5-25-74

MISSISSIPPI
 BOARD OF WATER COMMISSIONERS
 416 North State Street
 Jackson, Mississippi 39201

WATER WELL DRILLERS LOG

McNeil Well Works **Harrison** **CODED**

5-25-74
 date well completed

firm name

county well located

LANDOWNER:

Billy G. Byrd
 316 45th St.
 Gulfport, Miss.
 sec 36 T 6 S R 12 E W
 8 miles SW of Lumberton
 (distance) (direction) (nearest town)

description of formations encountered

from to

clay	0	20
sand	20	118
slush	118	146
blue clay	146	231
slush	231	308
Blue Clay	308	420
slush	420	476
rock	476	478
Blue Clay	478	492
Course Sand	492	525

WELL PURPOSE: Home
 (home, irrigation, municipal, industrial)

WELL COMPLETION DATA: May 25, 1974

- (1) diameter (inches) 2"
- (2) total depth (feet) 525'
- (3) static water level (feet) 65 ^{below} _{above} top of ground.
- (4) casing gal. 515'
 (material) (depth)
 X (size) if telescope see back.
- (5) screen 10' 515'
 (length) (depth to top)
2" stainless steel
 (size) (material)
- (6) pump 1 4 gal.
 (HP) (yield/gpm)
electric
 (type power)
- (7) electric log no
 (yes or no)
no
 (organization running log)

(8) how well bottom plugged and shaft
back wash water


DRILLERS REMARKS:

RECEIVED
OCT 25 1974

MISS. BD. OF WATER COMMISSIONERS

If well telescopes please sketch and show depths.

GROUND LEVEL

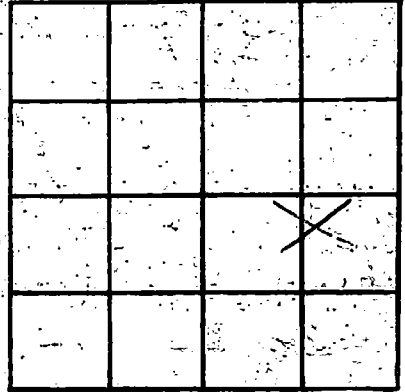

SECTION 36

Please indicate well location X.

ADDITIONAL INFORMATION

If more than one screen, show locations of each on sketch.