

HARRISON  
F170  
7-5-74

MISSISSIPPI  
BOARD OF WATER COMMISSIONERS  
416 North State Street  
Jackson, Mississippi 39201 CODED

WATER WELL DRILLERS LOG

July 5 1974 *McGill Well Works Harrison*  
date well completed firm name county well located

LANDOWNER:  
*Philip O. Allen*  
*Lumpkin Road*  
*Wilton, Miss*  
WELL LOCATION:  
sec. *34* T. *6* N. R. *12* E.  
*6* miles SW of *Lynn*  
(distance) (direction) (nearest town)


description of formations encountered	from	to
Clay	0	6
sand	16	31
shale	31	72
blue clay	72	131
fine sand	131	162
blue clay	162	218
shale	218	258
blue clay	258	341
fine sand	341	368
shale	368	392
blue clay	392	455
concrete lining	455	480

WELL PURPOSE: *drinking*  
(home, irrigation, municipal, industrial)

WELL COMPLETION DATA:  
(1) diameter (inches) *2"*  
(2) total depth (feet) *480*  
(3) static water level (feet) *42* below above top of ground.  
(4) casing *PVC* *470*  
(material) (depth)  
(size) if telescope see back.  
(5) screen *10'* *—*  
(length) (depth to top)  
*24* *55*  
(size) (material)  
(6) pump *1* *12*  
(HP) (yield gpm)  
*electric*  
(type power)  
(7) electric log *no*  
(yes or no)  
(organization running log)

(8) how well bottom plugged *sand & silt*  
*back wash water*

DRILLERS REMARKS:

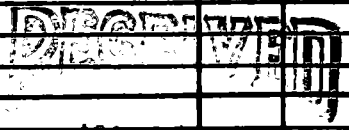

JAN 21 1975

If well telescopes please sketch and show depths.

GROUND LEVEL

X			

SECTION 34

Please indicate well location X.

ADDITIONAL INFORMATION

If more than one screen, show locations of each on sketch.