

HARRISON
F171
7-17-74

MISSISSIPPI
BOARD OF WATER COMMISSIONERS
416 North State Street
Jackson, Mississippi 39201

CODED

WATER WELL DRILLERS LOG

July 17 1974 *McCall Well Works Harrison*
date well completed firm name county well located

LANDOWNER: *Melrose Sims*
Et S Bot 908
Sheldon, Miss
WELL LOCATION:
sec *36 T 6 N R 1 E*
8 miles *(S)* of *Woolman*
(distance) (direction) (nearest town)

WELL PURPOSE: *Home*
(home, irrigation, municipal, industrial)

WELL COMPLETION DATA:
(1) diameter (inches) *2"*
(2) total depth (feet) *757*
(3) static water level (feet) *2* *(below above top of ground)*
(4) casing *PVC* *740*
(material) (depth)
If telescope see back.
(size)
(5) screen *10"* *740*
(length) (depth to top)
2" *SS.*
(size) (material)
(6) pump *1/2* *14*
(HP) (yield gpm)
electric
(type power)
(7) electric log *NO*
(yes or no)
(organization running log)

description of formations encountered	from	to
<i>clay</i>	<i>0</i>	<i>38</i>
<i>sand</i>	<i>38</i>	<i>72</i>
<i>blue clay</i>	<i>72</i>	<i>91</i>
<i>fine sand</i>	<i>91</i>	<i>118</i>
<i>bluish</i>	<i>118</i>	<i>136</i>
<i>fine sand</i>	<i>136</i>	<i>158</i>
<i>blue clay</i>	<i>158</i>	<i>182</i>
<i>bluish</i>	<i>182</i>	<i>198</i>
<i>fine sand</i>	<i>198</i>	<i>222</i>
<i>blue clay</i>	<i>222</i>	<i>247</i>
<i>bluish</i>	<i>247</i>	<i>291</i>
<i>blue clay</i>	<i>291</i>	<i>324</i>
<i>fine sand</i>	<i>324</i>	<i>397</i>
<i>blue clay</i>	<i>397</i>	<i>467</i>
<i>fine sand</i>	<i>467</i>	<i>504</i>
<i>blue clay</i>	<i>504</i>	<i>560</i>
<i>blue clay</i>	<i>560</i>	<i>618</i>
<i>bluish</i>	<i>618</i>	<i>654</i>
<i>blue clay</i>	<i>654</i>	<i>722</i>
<i>coarse sand</i>	<i>722</i>	<i>752</i>


RECORDED

JAN 21 1975

(8) how well bottom plugged *sand stuck*
crack what value
DRILLERS REMARKS:

If well telescopes please sketch and show depths.

GROUND LEVEL

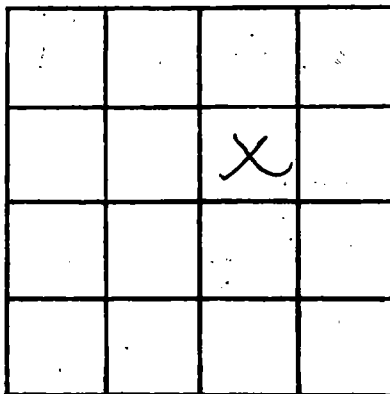

SECTION 36

Please indicate well location X.

ADDITIONAL INFORMATION

If more than one screen, show locations of each on sketch.