

HARRISON

~~Stone~~

J-10 F172

7-3-73

MISSISSIPPI  
BOARD OF WATER COMMISSIONERS  
416 North State Street  
Jackson, Mississippi 39201

**CODED**

WATER WELL DRILLERS LOG

~~STONE~~

July 3

date well completed

19 73 H.A. Ladnier's Well Works

firm name

HARRISON

county well located

LANDOWNER: Theo Lacy

description of formations encountered

from

to

Lizana, Mississippi  
(mailing address)

Blue Sand

0 40

Blue Clay

40 140

Yellow Clay

140 232

WELL LOCATION:

sec. 4 T. 46 N. R. 13 12 W  
S E W

8 miles west of Lyman  
(distance) (direction) (nearest town)

WELL PURPOSE: HOME  
(home, irrigation, municipal, industrial)

WELL COMPLETION DATA:

**CODED**

(1) diameter (inches) 2 inch

(2) total depth (feet) 232

(3) static water level (feet) 40 below above top of ground.

(4) casing Galv., 222,  
(material) (depth)

2 in. If telescope see back.  
(size)

(5) screen 10 ft., 222  
(length) (depth to top)

2 in., Stainless Steel  
(size) (material)

(6) pump 1 6  
(HP) (yield gpm)

Electric  
(type power)

(7) electric log NO  
(yes or no)

(organization running log)


(8) how well bottom plugged Ball Check

DRILLERS REMARKS:

MISS. Bd. of Water Comm.

If well telescopes please sketch and show depths.

GROUND LEVEL

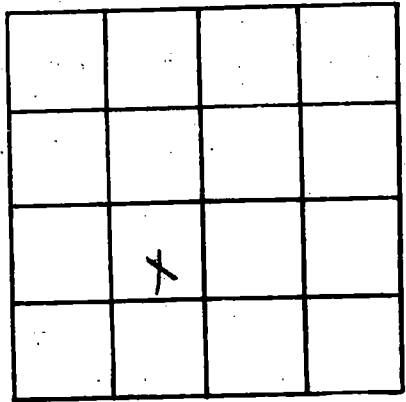

SECTION 4

Please indicate well location X.

ADDITIONAL INFORMATION

Lined area for additional information.

If more than one screen, show locations of each on sketch.