

Harrison  
 F173  
 10/18/74

MISSISSIPPI  
 BOARD OF WATER COMMISSIONERS  
 416 North State Street  
 Jackson, Mississippi 39201

CODED

WATER WELL DRILLERS LOG

10/18 1974 date well completed  
 24 Smith Water Co firm name  
 Harrison county well located

LANDOWNER: Dempsey  
Cheva. Lyons  
Corning  
 (mailing address)

description of formations encountered	from	to
red clay	0	50

WELL LOCATION:  
 sec 17 T 6 N R 12 E 13 S  
 2 miles SE of Lyons  
 (distance) (direction) (nearest town)

red sand fine	50	65
---------------	----	----

WELL PURPOSE: unknown  
 (home, irrigation, municipal, industrial)

WELL COMPLETION DATA:

(1) diameter (inches) 2"

(2) total depth (feet) 65

(3) static water level (feet) 30 below top of ground.

(4) casing PVC 55  
 (material) (depth)  
2 if telescope see back.  
 (size)

(5) screen 10 55  
 (length) (depth to top)  
2 galon screen  
 (size) (material)

(6) pump unk unk  
 (HP) (yield gpm)  
unk  
 (type power)

(7) electric log Y  
 (yes or no)  
 (organization running log)


(8) how well bottom plugged red  
shank

DRILLERS REMARKS:

RECEIVED  
 JUN 19 1975

If well telescopes please sketch and show depths.

GROUND LEVEL

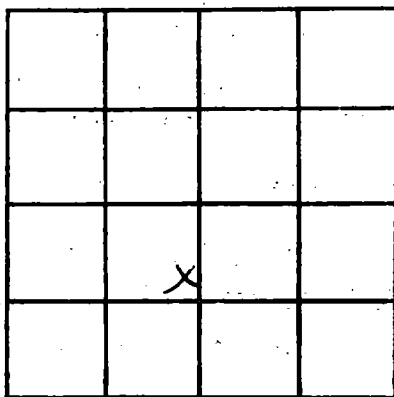

SECTION 17

Please indicate well location X.

ADDITIONAL INFORMATION

A series of horizontal lines for writing additional information, starting below the 'ADDITIONAL INFORMATION' header and extending to the bottom of the page.

If more than one screen, show locations of each on sketch.