

Harrison  
 F176  
 8-12-75

135

MISSISSIPPI  
 BOARD OF WATER COMMISSIONERS  
 416 North State Street  
 Jackson, Mississippi 39201

WATER WELL DRILLERS LOG

Aug. 12 1975 Ladnier's Well Works Harrison  
 date well completed firm name county well located

LANDOWNER: Trascclair  
 Hi way 53  
 Lizana, MS  
 (mailing address)

description of formations encountered	from	to
yellow clay	0	30
white sand	30	40
blue clay	40	202
blue sand	202	232

WELL LOCATION:  
 sec. 4 T. 6 S. R. 13 E.  
 2 1/2 miles NE of LIZANA  
 (distance) (direction) (nearest town)

WELL PURPOSE: home  
 (home, irrigation, municipal, industrial)

WELL COMPLETION DATA:

(1) diameter (inches) 2"

(2) total depth (feet) 232'

(3) static water level (feet) 8' below top of ground. 55'

(4) casing plastic, 80'  
 (material) (depth)  
 1" (size) if telescope see back.

(5) screen 20' (length) 212' (depth to top)  
 2" plastic (size) (material)

(6) pump 1 (HP) 8 (yield gpm)  
 elec (type power)

(7) electric log (yes or no)

(8) how well bottom plugged ball check


RECEIVED  
 OCT 23 1975

DRILLERS REMARKS:

MISSISSIPPI BOARD OF WATER COMMISSIONERS

If well telescopes please sketch and show depths.

GROUND LEVEL

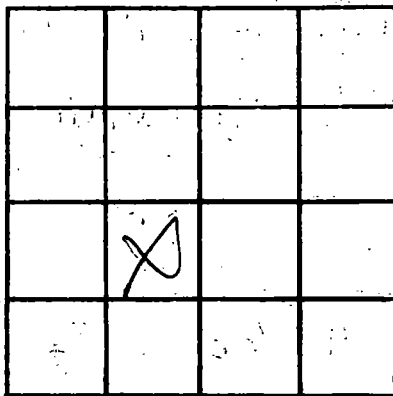

SECTION 4

Please indicate well location X.

ADDITIONAL INFORMATION

If more than one screen,  
show locations of each on sketch.