

Harrison  
F 177  
6-21-75

MISSISSIPPI  
 BOARD OF WATER COMMISSIONERS  
 416 North State Street  
 135 Jackson, Mississippi 39201


WATER WELL DRILLERS LOG

June 21 1975 H.A. Adnic's Well Works Harrison  
 date well completed firm name county well located

LANDOWNER:	description of formations encountered	from	to
<u>Shaw</u>			
<u>Hi-WAY 53</u>			
<u>LYMAN, Miss.</u> (mailing address)	<u>white &amp; yellow clay sand</u>	<u>0</u>	<u>80</u>
	<u>blue clay</u>	<u>80</u>	<u>590</u>
	<u>blue sand</u>	<u>590</u>	<u>630</u>
<b>WELL LOCATION:</b>			
sec. <u>2</u> T. <u>6</u> S. R. <u>12</u> W.			
<u>3</u> miles <u>NW</u> of <u>LYMAN</u>			
(distance) (direction) (nearest town)			
<b>WELL PURPOSE:</b> <u>home</u> (home, irrigation, municipal, industrial)			
<b>WELL COMPLETION DATA:</b>			
(1) diameter (Inches) <u>2 inches</u>			
(2) total depth (feet) <u>630 ft</u>			
(3) static water level (feet) <u>80</u> below top of ground.			
(4) casing <u>galv.</u> <u>630 ft.</u> (material) (depth)			
<u>2 in.</u> If telescope see back. (size)			
(5) screen <u>20 ft.</u> <u>630 ft.</u> (length) (depth to top)			
<u>2 in.</u> <u>Stainless Steel</u> (size) (material)			
(6) pump <u>2</u> <u>9</u> (HP) (yield gpm)			
<u>Elec.</u> (type power)			
(7) electric log <u>No</u> (yes or no)			
(organization running log)			
(8) how well bottom plugged <u>Ball Dec</u>			
<b>DRILLERS REMARKS:</b>			

If well telescopes please sketch and show depths.

GROUND LEVEL

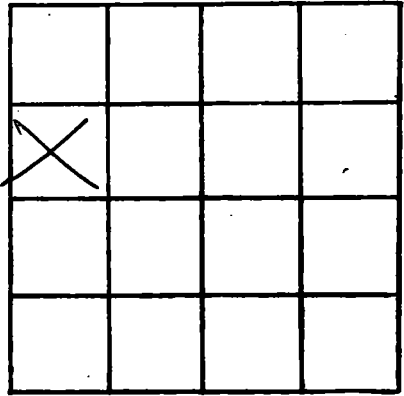

SECTION 2

Please indicate well location X.

ADDITIONAL INFORMATION

If more than one screen, show locations of each on sketch.