

HARRISON
F179
6-24-76

MISSISSIPPI
BOARD OF WATER COMMISSIONERS
 416 North State Street
 Jackson, Mississippi 39201

CODED

WATER WELL DRILLERS LOG
COASTAL DRILLING & SERVICE CO.

Harrison
 county well located

6/24 19 *76*
 date well completed ROUTE 1 BOX 618

LANDOWNER: *W. McCall*
Rt 2 Box 93
Hart, Miss.
 (mailing address)

description of formations encountered	from	to
<i>Top Soil</i>	<i>0</i>	<i>3</i>
<i>Red Clay</i>	<i>3</i>	<i>15</i>
<i>White Sand</i>	<i>15</i>	<i>20</i>
<i>Soft Blue Clay</i>	<i>40</i>	<i>230</i>
<i>Hard Blue Clay</i>	<i>230</i>	<i>360</i>
<i>Fine Water Sand</i>	<i>360</i>	<i>375</i>
<i>Coarse water Sand</i>	<i>375</i>	<i>400</i>

WELL LOCATION:
 sec *24* T *2* N R *12* E
 S W
3 1/2 miles *W* of *Jayron*
 (distance) (direction) (nearest town)

WELL PURPOSE: *Drain*
 (home, irrigation, municipal, industrial)

WELL COMPLETION DATA:

(1) diameter (inches) *4 1/2"*

(2) total depth (feet) *410'*

(3) static water level (feet) *60* below top of ground

(4) casing *Saw* *325'*
 (material) (depth)
4 1/2"
 (size) if telescope see back.

(5) screen *15* *325'*
 (length) (depth to top)
2" *all SS.*
 (size) (material)

(6) pump *2HP* *28*
 (HP) (yield gpm)
Edc
 (type power)

(7) electric log *no*
 (yes or no)

(organization running log)

CODED

(8) how well bottom plugged
2" backwash filter


DRILLERS REMARKS:
none

MISSISSIPPI BOARD OF WATER COMMISSIONERS
JACKSON, MISSISSIPPI
RECORDED
INDEXED
NOV 10 1976

If well telescopes please sketch and show depths.

GROUND LEVEL

200ft 4" glass casing

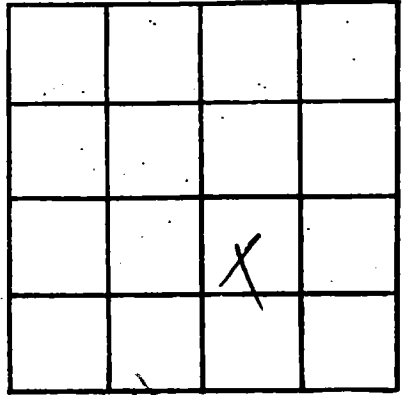

SECTION _____

Please indicate well location X.

ADDITIONAL INFORMATION

195' 2" glass casing

15' 2" All SS.
Screen

2" bed with valve

If more than one screen, show locations of each on sketch.